

# SURVEY & REMONUMENTATION

APR 24 1995

COMMISSION

## LAND CORNER RECORDATION CERTIFICATE Filing Requirement of Act 74, Mich. P.A. 1970

Approved by Menominee County  
Land Survey Remonumentation  
Four Group Under Act 345 of  
P.A. of 1990 On DEC 16 1994

*Mc Davis RLS*  
Chairman  
DEC 27 AM 10:46  
RECEIVED FOR RECORD  
BARBARA MORRISON  
REGISTER OF DEEDS  
MENOMINEE, MI 49858

For corners in MENOMINEE (County)

	Located In:	Corner Code #	
1. Public Land Survey	T <u>38N</u> R <u>25W</u>	<u>C-9</u>	
	T _____ R _____	_____	_____
	T _____ R _____	_____	_____
2. Property Controlling in Section	S _____ T _____ R _____	_____	_____
	S _____ T _____ R _____	_____	_____
3. Miscellaneous Property in Sec.	S _____ T _____ R _____	_____	_____
	S _____ T _____ R _____	_____	_____
4. Lot No. _____, Recorded Plat _____			
5. Private Claims _____			

Register of Deeds Stamp & File Number


I, William Lenca, in a field survey on Aug. 25, 1994, do hereby certify that under requirements of P.A. 74, Michigan P.A. of 1970, the corner points mentioned in lines 1 and 2 above were in conformance with regulations and rules therefore as required in the current manual of survey instructions of the United States Department of the Interior, Bureau of Land Management or by a decree of a Court of Law and/or that the corner points mentioned in lines 3, 4 and 5 above were in conformance with the rules of the Michigan Board of Land Surveyors or by a Decree of a Court of Law; established, re-established, monumented, re-monumented, recovered, found as expressed below:

	A	B	C	D	E	F	G	H	I	J	K	L	M
2	6	5	4	3	2	1							
3													
4	7	8	9	10	11	12							
5													
6	18	17	16	15	14	13							
7													
8	19	20	21	22	23	24							
9													
10	30	29	28	27	26	25							
11													
12	31	32	33	34	35	36							
13													

**NOTE: Not more than 4 corners, all in the same town and range, may be recorded on this certificate.**

A. Description of original monument and accessories and/or subsequent restoration:  
 1852: Original Survey by George E. Adair - B.T.'s - Tamarack, 8" - N48°E - 11 lks; Tamarack, 6" - S64°W - 40 lks - No original evidence for this corner was found.

B. Description of corner evidence found and/or method applied in restoring or reestablishing corner:  
 We set this corner at an ancient fence corner - fences run East and South from this location. This position agrees well with GLO distances to corners to the West, East and North. We accepted the old fence corner as the best available evidence of the position of the original corner.

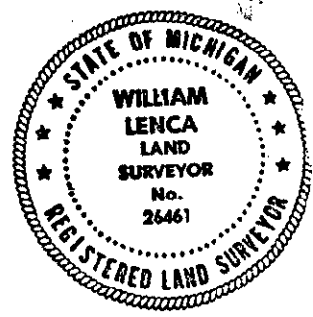

C. Description of monument for corner and accessories established to perpetuate locating the position of the corner:  
 Set 2-1/2" dia. alum. Pipe 30" long/3-1/4" dia. Alum. cap stamped for corner location:

9" dia. Cedar	N39°E	20.30 feet	Scr. NBT
6" dia. Cedar	S60°E	15.15 feet	Scr. NBT
9" dia. Cedar	S60°W	16.15 feet	Scr. NBT
9" dia. Cedar	N28°W	14.33 feet	Scr. NBT
Carsonite Marker	East	1.3 feet	

**NOTE: All bearings are magnetic bearings. All distances are measured with steel tape. Distances to trees are to nail in side of tree.**

Signed by William Lenca Date Sep. 15, 1994  
 Surveyor's Michigan License No. 26461