

SURVEY & REMONUMENTATION

APR 06 1999

SECTION

LAND CORNER RECORDATION CERTIFICATE
Filing Requirement of Act 74, Mich. P.A. 1970

Approved by Menominee County
Land Survey Remonumentation
Peer Group Under Act 345 Of
P.A. of 1990 On DEC 16 1994
MEL DAVIS PLS

For corners in

MENOMINEE
(County)

Located In:

Corner Code ##

- | | | |
|------------------------------------|---------------------------|------------|
| 1. Public Land Survey | T <u>37N</u> R <u>25W</u> | <u>K-1</u> |
| | T _____ R _____ | _____ |
| | T _____ R _____ | _____ |
| | T _____ R _____ | _____ |
| 2. Property Controlling in Section | S _____ T _____ R _____ | _____ |
| | S _____ T _____ R _____ | _____ |
| 3. Miscellaneous Property in Sec. | S _____ T _____ R _____ | _____ |
| | S _____ T _____ R _____ | _____ |

RECEIVED FOR RECORD
DEC 27 AM 10:47
BARBARA MORRISON
REGISTER OF DEEDS
MICHIGAN
REGISTERED 11/16/1983
BK. 9
Register of Deeds Stamp & File Number

4. Lot No. _____, Recorded Plat _____
5. Private Claims _____

K-13 T 38N - R 25W

I, William Lenca, in a field survey on Sep 23, 19 94, do hereby certify that under requirements of P.A. 74, Michigan P.A. of 1970, the corner points mentioned in lines 1 and 2 above were in conformance with regulations and rules therefore as required in the current manual of survey instructions of the United States Department of the Interior, Bureau of Land Management or by a decree of a Court of Law and/or that the corner points mentioned in lines 3, 4 and 5 above were in conformance with the rules of the Michigan Board of Land Surveyors or by a Decree of a Court of Law; established, re-established, monumented, re-monumented, recovered, found as expressed below:

NOTE: Not more than 4 corners, all in the same town and range, may be recorded on this certificate.

A	B	C	D	E	F	G	H	I	J	K	L	M
2	6	5	4	3	2	1						
3												
4	7	8	9	10	11	12						
5												
6	18	17	16	15	14	13						
7												
8	19	20	21	22	23	24						
9												
10	30	29	28	27	26	25						
11												
12	31	32	33	34	35	36						
13												

A. Description of original monument and accessories and/or subsequent restoration:

- 1847: Original Survey (Township Lines) by Henry Floyd - B.T.'s - Tamarack, 10"- N10°W, 32 lks; Tamarack, 10" - N27°E - 07 lks. No original evidence found.
- 1853: Original Survey (Section Subdivision) by George Adair - B.T.'s - Tamarack, 10" - S03°E - 14 lks; Spruce, 8" - S72°W - 35 lks.
- 1968: L.C.R.C. No. 677-Vol 3 by Frank J. Bray, DNR Surveyor, states that a 1" dia. Iron Pipe/4" dia. Alum. cap was set in place of old wood post with points of older stakes found along side. Found overgrowth of notch of B.T. to SE. B.T. to NW chopped out. Rotted stump bottoms of B.T.'s to NE and SW. New B.T.'s - 4" B. Spruce - N52°W - 7.5 lks; 10" Cedar - S75°E - 16 lks.


B. Description of corner evidence found and/or method applied in restoring or reestablishing corner:

We found a 1" dia. Iron Pipe/4" dia. Alum. cap and 2 Bearing Trees as described in part "A". The Spruce B.T. - N52°W - 7.5 lks - was broken off. We also found the old wood stakes along side the corner monument, and remnants of the rotted stump bottoms to the NE and SW. Our measured distance West to the edge of swamp and foot of hill (572 feet) fits very well with the GLO call (8.5 chains or 561 feet). We accepted this location as the best available evidence of the position of the original corner.

C. Description of monument for corner and accessories established to perpetuate locating the position of the corner:

Accepted existing 1" dia. Iron Pipe/3-1/4" dia. Alum. cap stamped for corner location:

9" dia. Black Spruce	N13°E	24.60 feet	Scr. NBT
20" dia. Cedar - (Ex. B.T.)	S75°E	11.04 feet	Scr. NBT
8" dia. Black Spruce	S31°W	26.06 feet	Scr. NBT
6" dia. Cedar	N37°W	15.17 feet	Scr. NBT
Survey Sign Post	N50°E	1.6 feet	

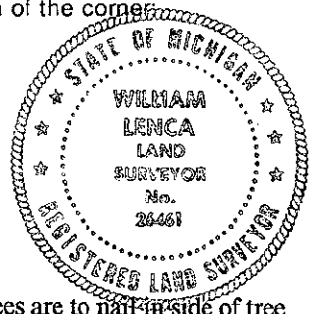

NOTE: All bearings are magnetic bearings. All distances are measured with steel tape. Distances to trees are to nail in side of tree.

Signed by William Lenca Date Nov. 15, 1994

Surveyor's Michigan License No. 26461

172