

**SURVEY & REMONUMENTATION**

**JAN 09 2001**

**SECTION**


**LAND CORNER RECORDATION CERTIFICATE**  
Filing Requirement of Act 74, Mich. P.A. 1970

Approved by Menominee County  
Land Survey Remonumentation  
Peer Group Under Act 345 of  
P.A. Of 1990 On 12/22, 2000  
W. Lenca  
Chairman

For corners in  
MENOMINEE  
(County)

	Located In:	Corner Code #
1. Public Land Survey	T <u>38N</u> R <u>26W</u>	<u>A-08</u>
	T <u>    </u> R <u>    </u>	<u>    </u>
	T <u>    </u> R <u>    </u>	<u>    </u>
	T <u>    </u> R <u>    </u>	<u>    </u>
2. Property Controlling in Section	S <u>    </u> T <u>    </u> R <u>    </u>	<u>    </u>
	S <u>    </u> T <u>    </u> R <u>    </u>	<u>    </u>
3. Miscellaneous Property in Sec.	S <u>    </u> T <u>    </u> R <u>    </u>	<u>    </u>
	S <u>    </u> T <u>    </u> R <u>    </u>	<u>    </u>

Bk. 6 Pg. 199

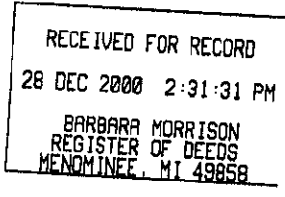

Register of Deeds Stamp & File Number

4. Lot No. \_\_\_\_\_, Recorded Plat \_\_\_\_\_  
5. Private Claims \_\_\_\_\_  
SAME AS CORNER M-8 T38N-R27W

I, William Lenca, in a field survey on Aug. 15, 19     do hereby state that under requirements of P.A. 74, Michigan P.A. of 1970, the corner points mentioned in lines 1 and 2 above were in conformance with regulations and rules therefore as required in the current manual of survey instructions of the United States Department of the Interior, Bureau of Land Management or by a decree of a Court of Law and/or that the corner points mentioned in lines 3, 4 and 5 above were in conformance with the rules of the Michigan Board of Land Surveyors or by a Decree of a Court of Law; established, re-established, monumented, recovered, found as expressed below:

NOTE: Not more than 2 corners, all in the same town and range, may be recorded on this certificate.

1	A	B	C	D	E	F	G	H	I	J	K	L
2	6			5		4		3		2		1
3												
4	7			8		9		10		11		12
5												
6	10			17		16		15		14		13
7												
8	19			20		21		22		23		24
9												
10	30			29		28		27		26		25
11												
12	31			32		33		34		35		36
13												

A. Description of original monument and accessories and/or subsequent restoration:

1848: Original Survey by James H. Mullett - B.T.'s - Hcmlock, 14" - N70°W - 13 lks.; Cedar, 12" - S37°W - 15 lks. All original evidence for this corner has been destroyed by farming activities.


B. Description of corner evidence found and/or method applied in restoring or reestablishing corner:

We found a 1/2 inch x 8 inch iron pipe set by unknown persons at an ancient fence corner running East - West and South and at a distance of 2635.95 feet South of the NW Corner of Section 19, T38N-R26W. We accepted this position as the best available evidence of the position of the original corner.

C. Description of monument for corner and accessories established to perpetuate locating the position of the corner:

Set 3/4" dia. x 4' long aluminum rod/3-1/4" dia. Alum. cap stamped for corner.

6" dia. Cedar	N30°E	53.05 feet	Scr. NBT
9" dia. Maple	S55°E	50.15 feet	Scr. NBT
7" dia. Elm	South	15.87 feet	Scr. NBT
Power Pole	N55°W	71.21 feet	
Metal Survey Sign Post	East	0.75 feet	

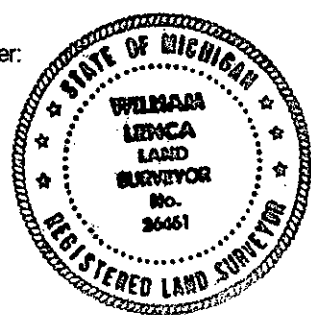

NOTE: All bearings are magnetic bearings. All distances are measured with steel tape. Distances to trees are to nail in side of tree.

Signed by William Lenca  
Surveyor's Michigan License No. 26461

Date Sept. 8, 2000