

# SURVEY & REMONUMENTATION

JAN 09 2001

## SECTION

### LAND CORNER RECORDATION CERTIFICATE Filing Requirement of Act 74, Mich. P.A. 1970

Approved by Menominee County  
Land Survey Remonumentation  
Peer Group Under Act 345 of  
P.A. of 1990 On 12/22, 2000  
Wm. Lenca RLS  
Chairman

For corners in  
MENOMINEE

(County)

Located In:

Corner Code #

1. Public Land Survey		T <u>38N</u> R <u>26W</u>			B-09
		T ___ R ___			_____
		T ___ R ___			_____
		T ___ R ___			_____
2. Property Controlling in Section	S ___	T ___ R ___			_____
	S ___	T ___ R ___			_____
3. Miscellaneous Property in Sec.	S ___	T ___ R ___			_____
	S ___	T ___ R ___			_____

Blk. 6 Pg. 201

RECEIVED FOR RECORD  
28 DEC 2000 2:31:31 PM  
BARBARA MORRISON  
REGISTER OF DEEDS  
MENOMINEE, MI 49858

Register of Deeds Stamp & File Number

4. Lot No. \_\_\_\_\_, Recorded Plat \_\_\_\_\_  
5. Private Claims \_\_\_\_\_

I, William Lenca, in a field survey on Aug. 15, 1900 do hereby state that under requirements of P.A. 74, Michigan P.A. of 1970, the corner points mentioned in lines 1 and 2 above were in conformance with regulations and rules therefore as required in the current manual of survey instructions of the United States Department of the Interior, Bureau of Land Management or by a decree of a Court of Law and /or that the corner points mentioned in lines 3, 4 and 5 above were in conformance with the rules of the Michigan Board of Land Surveyors or by a Decree of a Court of Law; established, re-established, monumented, recovered, found as expressed below:

NOTE: Not more than 2 corners, all in the same town and range, may be recorded on this certificate.

	A	B	C	D	E	F	G	H	I	J	K	L
1												
2		6		5		4		3		2		1
3												
4		7		8		9		10		11		12
5												
6		18		17		16		15		14		13
7												
8		19		20		21		22		23		24
9		20										
10		30		29		28		27		26		25
11												
12		31		32		33		34		35		36
13												

**A. Description of original monument and accessories and/or subsequent restoration:**

- 1852: Original Survey by George Adair - B.T.'s - Y. Birch, 9" - N64°W - 09 lks; Cedar - S65°E - 21 lks. All original evidence for this corner has been destroyed by farming and clearing activities.
- 1989: L.C.R.C. No. 854 (Book 3) recorded by William Lenca, RLS No. 26461: Set 5/8" x 24" Iron Rod/Ident. cap in line with Co. Rd. centerlines E & S. Fits closely with GLO terrain call to the East (Swamp edge 22 feet east). TIES: 5" Cedar - S20°W - 8.51'; 5" Cedar - N65°W - 58.46'; 8" Tamarack - North - 38.17'.


**B. Description of corner evidence found and/or method applied in restoring or reestablishing corner:**

We recovered our 5/8 inch iron rod and 2 B.T.'s in place as described in L.C.R.C. No. 854 (see part "A"). The Cedar B.T. S20°W, 8.51 feet has been blown down. This corner position fits well with existing lines of occupation and with measurements to corners 1/2 mile East and 1/2 mile West and is accepted as the best available evidence of the position of the original corner.

**C. Description of monument for corner and accessories established to perpetuate locating the position of the corner:**

Set 2" dia. Aluminum Pipe 30" long/3-1/4" dia. Alum cap stamped for corner location:

10" dia. Tamarack (Ex. B.T.)	North	38.17 feet	Scr. NBT
4" dia. Cedar	S28°W	13.00 feet	Scr. NBT
6" dia. Cedar (Ex. B.T.)	N65°W	58.25 feet	Scr. NBT
Metal Survey Sign Post	East	1.3 feet	
Nothing else usable nearby			

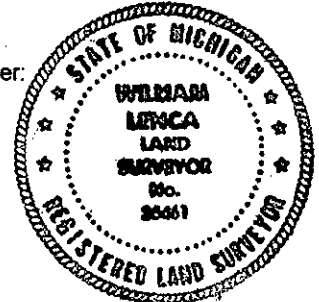

NOTE: All bearings are magnetic bearings. All distances are measured with steel tape. Distances to trees are to nail in side of tree.

Signed by William Lenca  
Surveyor's Michigan License No. 26461

Date Sept. 8, 2000