

SURVEY & REMONUMENTATION

JAN 09 2001

SECTION

LAND CORNER RECORDATION CERTIFICATE

Filing Requirement of Act 74, Mich. P.A. 1970

Approved by Menominee County
Land Survey Remonumentation
Peer Group Under Act 345 of
P.A. Of 1999 On 12/22, 2000
McDermott RLS
Chairman

Bk. 6 Pg. 224

RECEIVED FOR RECORD
28 DEC 2000 2:31:31 PM
BARBARA MORRISON
REGISTER OF DEEDS
MENOMINEE, MI 49858


Register of Deeds Stamp & File Number

For corners in MENOMINEE (County)	Located In:	Corner Code #
1. Public Land Survey	T 38NR 26W	F-03
	T R	
	T R	
	T R	
2. Property Controlling in Section	S T R	
	S T R	
3. Miscellaneous Property in Sec.	S T R	
	S T R	

4. Lot No. _____, Recorded Plat _____
5. Private Claims _____

I, William Lenca, in a field survey on Oct. 9, 1900 do hereby state that under requirements of P.A. 74, Michigan P.A. of 1970, the corner points mentioned in lines 1 and 2 above were in conformance with regulations and rules therefore as required in the current manual of survey instructions of the United States Department of the Interior, Bureau of Land Management or by a decree of a Court of Law and/or that the corner points mentioned in lines 3, 4 and 5 above were in conformance with the rules of the Michigan Board of Land Surveyors or by a Decree of a Court of Law, established, re-established, monumented, recovered, found as expressed below:

NOTE: Not more than 2 corners, all in the same town and range, may be recorded on this certificate.

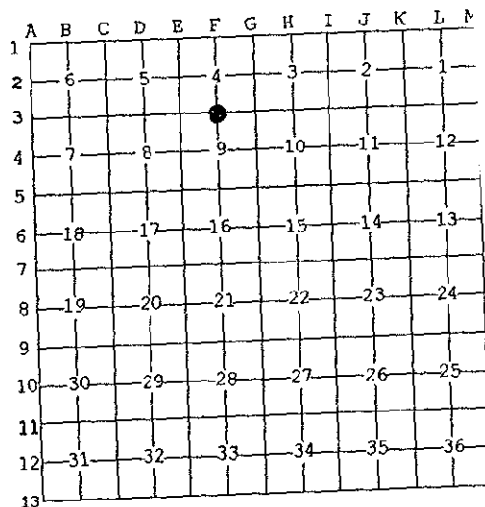

A. Description of original monument and accessories and/or subsequent restoration:

- 1852: Original Survey by George Adair - B.T.'s - Beech, 7" - N29°W - 06 lks; Beech - S39°E - 12 lks. All original evidence for this corner has been destroyed by county road improvements.
- 1984: L.C.R.C. No. 652 (Book 2) recorded by Neil E. Hill, RLS No. 27447: Fnd 1/2 PIN - TIES: 2" Poplar - N40°E - 40.23'; P. Pole - S50°W - 49.75'; Tri 11" Basswood - S75°W - 50.77'; Mail Box - N70°W - 33.54'.
- 1984: Plat of Survey by MDOT Party Chief Neil E. Hill, RLS No. 27447 showing this corner as it relates to other corners in Section 9, T38N-R26W.

B. Description of corner evidence found and/or method applied in restoring or reestablishing corner:

We recovered a 1/2 inch diameter iron pin and 1 tie (P. Pole - S50°W - 49.75 feet) in place as described in L.C.R.C. No. 652, Book 2 (see part A). The corner is located in the center of the intersection of county roads running North - South and East, and in line with the centerline of a gravel drive to the West. This position also fits closely with a single proportional location, has been accepted and used by local surveyors for several years, and is accepted as the best available evidence for the position of the original corner.

C. Description of monument for corner and accessories established to perpetuate locating the position of the corner:

Set 5/8" x 24" Iron Rod/3-1/4" dia. Alum. cap stamped for corner location:

5/8" x 24" Iron Rod/2" dia. Alum. cap marked "WITNESS MARKER"	N38°E	40.44 feet	1.0' E. of Tel. Pedestal
5/8" x 24" Iron Rod/2" dia. Alum. cap marked "WITNESS MARKER"	S56°E	60.04 feet	1.0' W. of Fence Corner
5/8" x 24" Iron Rod/2" dia. Alum. cap marked "WITNESS MARKER"	S43°W	50.17 feet	1.0' N. of Power Pole
15" dia. White Ash	N64°W	65.94 feet	Scr. NBT
Steel Survey Sign Post	S66°W	35.9 feet	

NOTE: All bearings are magnetic bearings. All distances are measured with steel tape. Distances to trees are to nail in side of tree.

Signed by William Lenca
Surveyor's Michigan License No. 26461

Date Dec. 16, 2000

