


LAND CORNER RECORDATION CERTIFICATE
Filing Requirement of Act 74, Mich. P.A. 1970

P.A. of 1990 On 12/27, 1996
W. Lenca
Chairman

For corners in

<u>MENOMINEE</u> (County)	Located In:	Corner Code #
1. Public Land Survey	T <u>18N</u> R <u>26W</u>	<u>K-4</u>
	T <u> </u> R <u> </u>	<u> </u>
	T <u> </u> R <u> </u>	<u> </u>
2. Property Controlling in Section	S <u> </u> T <u> </u> R <u> </u>	<u> </u>
	S <u> </u> T <u> </u> R <u> </u>	<u> </u>
3. Miscellaneous Property in Sec.	S <u> </u> T <u> </u> R <u> </u>	<u> </u>
	S <u> </u> T <u> </u> R <u> </u>	<u> </u>

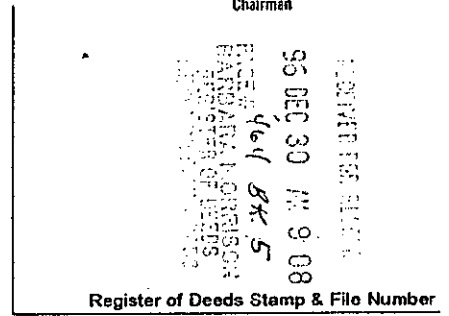

4. Lot No. _____, Recorded Plat _____
5. Private Claims _____

I, William Lenca, in a field survey on Nov. 27, 1996 do hereby state that under requirements of P.A. 74, Michigan P.A. of 1970, the corner points mentioned in lines 1 and 2 above were in conformance with regulations and rules therefore as required in the current manual of survey instructions of the United States Department of the Interior, Bureau of Land Management or by a decree of a Court of Law and for that the corner points mentioned in lines 3, 4 and 5 above were in conformance with the rules of the Michigan Board of Land Surveyors or by a Decree of a Court of Law, established, re-established, monumented, recovered, found as expressed below:

NOTE: Not more than 2 corners, all in the same town and range, may be recorded on this certificate.


A	B	C	D	E	F	G	H	I	J	K	L	M
1												
2	6		5		4		3		2		1	
3												
4	7		8		9		10		11		12	
5												
6	18		17		16		15		14		13	
7												
8	19		20		21		22		23		24	
9												
10	30		29		28		27		26		25	
11												
12	31		32		33		34		35		36	
13												

A. Description of original monument and accessories and/or subsequent restoration:

- 1852: Original Survey by George Adair - B.T.'s - Cedar, 11" - N32°E - 18 lks.; Cedar, 13" - S56°W - 15 lks. All original evidence for this corner has been destroyed by county road improvements.
- 1978: Robert Perkins, RLS No. 12027, shows this corner on a survey map and describes it as "Found capped iron pipe buried in road c/1 - B.T.'s - Cedar, 6" - N73°E - 51.7'; P. Pole - S18°W - 140.75'.
- 1984: L.C.R.C. No. 671 by Neil Hill, RLS No. 27447, states "found 24" T-Bar w/cap - B.T.'s - 8" Cedar B.T. - N70E - 51.55'; 12" Tamarack - S80°E - 58.30'.
- 1995: Certified Survey No. 836 by Edward Kazianka, RLS No. 14765, states 1/2" iron rod found - B.T.'s - 6" Aspen - S79°E - 46.55'; P. Pole - S56°W - 40.20'.

B. Description of corner evidence found and/or method applied in restoring or reestablishing corner:

We found a 5/8 inch diameter iron rod in a North - South County Road matching the B.T.'s given in Certified Survey No. 836. We were unable to find the B.T.'s mentioned in L.C.R.C. No. 671, but the location of the existing iron matches a 1984 Plat of Survey by Neil Hill (M.D.O.T. Crew Chief). This corner falls at a single proportional position between Section Corners, and is accepted as a careful and faithful reestablishment of the position of the original corner.

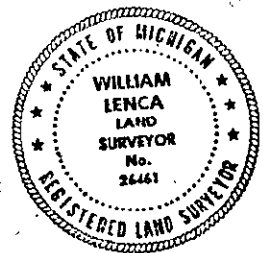

C. Description of monument for corner and accessories established to perpetuate locating the position of the corner:
Set 3-1/4" dia. Aluminum cap on existing 5/8" dia. Iron Rod and stamped for corner:

5/8" x 24" Iron Rod/2" dia. Alum cap marked "WITNESS MARKER	S83°E	46.45 feet	0.6' N. of 6" Poplar
3" dia. Tamarack	S31°E	69.60 feet	Scr. NBT
6" dia. Jack Pine	S22°W	66.11 feet	Scr. NBT
5/8" x 24" Iron Rod/2" dia. Alum cap marked "WITNESS MARKER	N90°W	28.15 feet	
Metal Survey Sign Post	N90°W	28.6 feet	

NOTE: All bearings are magnetic bearings. All distances are measured with steel tape. Distances to trees are to nail in side of tree.

Signed by William Lenca Date Dec. 19, 1996
Surveyor's Michigan License No. 26461

464