

LAND CORNER RECORDATION CERTIFICATE
 Filing Requirement of Act 74, Mich. P.A. 1970


For corners in
MENOMINEE
 (County)

Located In: Corner Code #

1. Public Land Survey T8N R26W K5
 T R
 T R
 T R

2. Property Controlling
 in Section S T R
 S T R

3. Miscellaneous
 Property in Sec. S T R
 S T R

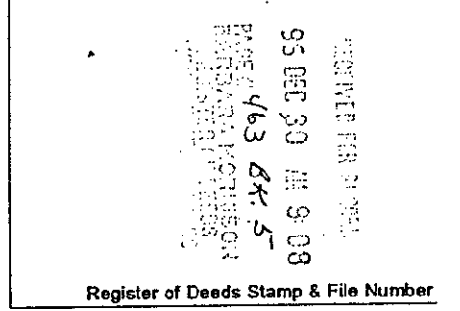

4. Lot No. _____, Recorded Plat _____
 5. Private Claims _____

I, William Lenca, in a field survey on Nov 27, 1996 do hereby state that under requirements of P.A. 74, Michigan P.A. of 1970, the corner points mentioned in lines 1 and 2 above were in conformance with regulations and rules therefore as required in the current manual of survey instructions of the United States Department of the Interior, Bureau of Land Management or by a decree of a Court of Law and/or that the corner points mentioned in lines 3, 4 and 5 above were in conformance with the rules of the Michigan Board of Land Surveyors or by a Decree of a Court of Law, established, re-established, monumented, recovered, found as expressed below.

A	B	C	D	E	F	G	H	I	J	K	L	M
1												
2	6	5	4	3	2	1						
3												
4	7	8	9	10	11	12						
5												
6	10	17	16	15	14	13						
7												
8	19	20	21	22	23	24						
9												
10	30	29	28	27	26	25						
11												
12	31	32	33	34	35	36						
13												

NOTE: Not more than 2 corners, all in the same town and range, may be recorded on this certificate.

- A. Description of original monument and accessories and/or subsequent restoration:
- 1852: Original Survey by George Adair - B.T.'s - W. Pine, 10" - N47°E - 11 lks.; Cedar, 10" - S21°W - 14 lks. All original evidence for this corner has been destroyed by county road improvements.
 - 1984: L.C.R.C. No. 672 by Neil Hill, RLS No. 27447, states "found bent iron pipe in c/I Co. Rd. @ fence East. Location fits occupation and comparison of GLO distances to existing corner monumentation is reasonable. Replaced bent iron with drift pin." B.T.'s: 4" Balsam - S55°E - 22.98'; 9" W. Pine - N20°W - 58.00'; 8" Ash - S80°E - 24.51'; 8" W. Pine - S45°W - 25.60'.

B. Description of corner evidence found and/or method applied in restoring or reestablishing corner:

We recovered a 3/4 inch diameter x 18 inch iron pipe in the centerline of a North - South County Road, and in line with an ancient fence line running East. We also found the 2 White Pine B.T.'s described in L.C.R.C. No. 672 matching the position of the found iron pipe. This corner has been accepted and used by local surveyors for many years, and is accepted as the best available evidence of the position of the original corner.

- C. Description of monument for corner and accessories established to perpetuate locating the position of the corner.
 Set 2" dia. Aluminum Pipe/3-1/4" dia. Alum cap stamped for corner location:
- | | | | |
|---------------------------------------|-------|------------|----------|
| 5" dia. Cedar | N75°E | 27.27 feet | Scr. NBT |
| 10" dia. White Pine | S52W | 28.79 feet | Scr. NBT |
| 12" dia. White Pine - (Existing B.T.) | N20°W | 58.00 feet | Scr. NBT |
| 5" dia. Cedar | S39°E | 80.49 feet | Scr. NBT |
| Metal Survey Sign Post | N80°E | 20.8 feet | |



NOTE: All bearings are magnetic bearings. All distances are measured with steel tape. Distances to trees are to nail in side of tree.

Signed by William Lenca Date Dec. 23, 1996
 Surveyor's Michigan License No. 26461

463