

SURVEY & REMONUMENTATION

MAR 29 2000

SECTION

LAND CORNER RECORDATION CERTIFICATE
Filing Requirement of Act 74, Mich. P.A. 1970

Approved by Menominee County
Land Survey Remonumentation
Peer Group Under Act 345 Of
P.A. Of 1990 On 12/23 1999
McL Davis RLS
Chairman

For corners in
MENOMINEE
(County)

Located In: Corner Code #

1. Public Land Survey	T <u>38N</u> R <u>27W</u>	<u>K05</u>
	T ___ R ___	___
	T ___ R ___	___
	T ___ R ___	___
2. Property Controlling in Section	S ___ T ___ R ___	___
	S ___ T ___ R ___	___
3. Miscellaneous Property in Sec.	S ___ T ___ R ___	___
	S ___ T ___ R ___	___

BK. 6 Pg. 39

RECEIVED FOR RECORD
28 DEC 1999 3:56:09 PM
BARBARA MORRISON
REGISTER OF DEEDS
MENOMINEE, MI 49858

Register of Deeds Stamp & File Number

4. Lot No. _____, Recorded Plat _____
5. Private Claims _____

I, William Lenca, in a field survey on June, 1999 do hereby state that under requirements of P.A. 74, Michigan P.A. of 1970, the corner points mentioned in lines 1 and 2 above were in conformance with regulations and rules therefore as required in the current manual of survey instructions of the United States Department of the Interior, Bureau of Land Management or by a decree of a Court of Law and /or that the corner points mentioned in lines 3, 4 and 5 above were in conformance with the rules of the Michigan Board of Land Surveyors or by a Decree of a Court of Law; established, re-established, monumented, recovered, found as expressed below:

A	B	C	D	E	F	G	H	I	J	K	L	M
1												
2	6	5	4	3	2	1						
3												
4	7	8	9	10	11	12						
5												
6	18	17	16	15	14	13						
7												
8	19	20	21	22	23	24						
9												
10	30	29	28	27	26	25						
11												
12	31	32	33	34	35	36						
13												

NOTE: Not more than 2 corners, all in the same town and range, may be recorded on this certificate.

A. Description of original monument and accessories and/or subsequent restoration:

- 1852: Original Survey by Harvey Mellen - B.T.'s - Cedar, 10" - N82°W - 12 lks.; Cedar, 12" - S58°E - 40 lks. All original evidence for this corner has been destroyed by County Road improvements.
- 1982: L.C.R.C. No. 553 by James Moore, RLS No. 28423 - Found Railroad Spike in centerline of County Roads. TIES: W. Birch, 7" - N85°W - 78.10'; Power Pole - N50°W - 50.65'; Spruce, 4" - N45°E - 56.98'.


B. Description of corner evidence found and/or method applied in restoring or reestablishing corner:

We recovered a Railroad Spike in the centerline of a County Road running North - South and East. We also found the 3 ties described in LCRC No. 553 (see part A above) which fit the railroad spike. This corner position fits well with measurements to corners North and East and also fits well with existing lines of occupation. The existing railroad spike has been accepted and used by local surveyors for at least 17 years, and is accepted as the best available evidence of the position of the original corner.

C. Description of monument for corner and accessories established to perpetuate locating the position of the corner:

Set 5/8" x 24" Iron Rod/3-1/4" dia. Alum. cap stamped for corner location in Monument Box:

5" dia. Tamarack	N32°E	61.84 feet	Scr. NBT
5" dia. Tamarack	S68°W	61.34 feet	Scr. NBT
5/8" x 24" Iron Rod/2" dia. Alum. cap marked "WITNESS MARKER"	N85°W	37.34 feet	
9" dia. Maple	N42°W	91.64 feet	Scr. NBT
Metal Survey Sign Post	N85°W	37.84 feet	

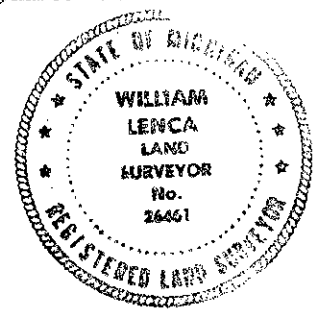

NOTE: All bearings are magnetic bearings. All distances are measured with steel tape. Distances to trees are to nail in side of tree.

Signed by William Lenca
Surveyor's Michigan License No. 26461

Date July 9, 1999