

SURVEY & REMONUMENTATION

MAR 29 2000

LAND CORNER RECORDATION CERTIFICATE
Filing Requirement of Act 74, Mich. P.A. 1970

Approved by Menominee County
Land Survey Remonumentation
Peer Group Under Act 345 Of

P.A. of 1999 On 12/28 1999
McL. Amari RLS
Chairman

BK. 6 Pg. 43

RECEIVED FOR RECORD
28 DEC 1999 3:56:09 PM
BARBARA MORRISON
REGISTER OF DEEDS
MENOMINEE, MI 49858

Register of Deeds Stamp & File Number

For corners in
MENOMINEE
(County)

Located In:	Corner Code #
T 38N R 27W	M05
T R	
T R	
T R	
S T R	
S T R	
S T R	
S T R	

- Public Land Survey
- Property Controlling in Section
- Miscellaneous Property in Sec.

4. Lot No. _____, Recorded Plat _____
5. Private Claims _____
SAME AS CORNER A-5, T38N-R26W

I, William Lenca, in a field survey on June, 1999 do hereby state that under requirements of P.A. 74, Michigan P.A. of 1970, the corner points mentioned in lines 1 and 2 above were in conformance with regulations and rules therefore as required in the current manual of survey instructions of the United States Department of the Interior, Bureau of Land Management or by a decree of a Court of Law and /or that the corner points mentioned in lines 3, 4 and 5 above were in conformance with the rules of the Michigan Board of Land Surveyors or by a Decree of a Court of Law; established, re-established, monumented, recovered, found as expressed below:

NOTE: Not more than 2 corners, all in the same town and range, may be recorded on this certificate.


	A	B	C	D	E	F	G	H	I	J	K	L	M
1													
2	6	5	4	3	2	1							
3													
4	7	8	9	10	11	12							
5													
6	18	17	16	15	14	13							
7													
8	19	20	21	22	23	24							
9													
10	30	29	28	27	26	25							
11													
12	31	32	33	34	35	36							
13													

- A. Description of original monument and accessories and/or subsequent restoration:
- 1848: Original Survey (Twp. Lines) by H. Brevoort - B.T.'s - Lynn, 14" - S35°W - 19 lks.; Sugar, 18" - N34°W - 11 lks. All original evidence for this corner has been destroyed by county road improvements.
 - 1852: Original Survey (Sec. Subd.) by George Adair - B.T.'s - Lynn, 18" - N79°E - 31 lks; Lynn, 14" - S48°E - 02 lks. All original evidence for this corner has been destroyed by county road improvements.

B. Description of corner evidence found and/or method applied in restoring or reestablishing corner:

There is a short stub of an ancient fence line running South from an East - West fence on the North side of a County Road. The distance from this fence West to the S1/4 Corner is 2669.53 feet. The distance West to the 1/16 fence is 1335. The GLO distance from the SW Corner of Section 12 East to the SE Corner is 5324.88 feet compared to our measured distance of 5325.89 feet. We therefore set the corner in line with the fence stub and in the centerline of the County Road running East - West and accepted this location as the best available evidence of the position of the original corner.

- C. Description of monument for corner and accessories established to perpetuate locating the position of the corner:
- Set 2" dia. Aluminum Pipe 30" long/3-1/4" dia. Alum cap stamped for corner location:
- | | | | |
|------------------------|-------|------------|----------|
| 6" dia. Maple | N40°E | 31.43 feet | Scr. NBT |
| 12" dia. Maple | S60°E | 43.34 feet | Scr. NBT |
| 16" dia. Maple | S15°W | 17.20 feet | Scr. NBT |
| Metal Survey Sign Post | South | 1.1 feet | |

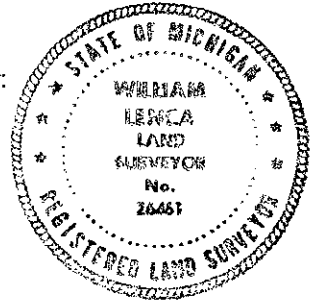

NOTE: All bearings are magnetic bearings. All distances are measured with steel tape. Distances to trees are to nail in side of tree.

Signed by William Lenca
Surveyor's Michigan License No. 26461

Date July 9, 1999