
Approved by	Menominee Coun
land Survey	Remonumentatio
ree Group	Under Act 345 Of

					Pj	. Of 19	90 Gn	12/	30	., 199 🕰	
SECTION							11/2	BA	us i	215	
For corners in			RECORDATION Port of Act 74, N			Ī		iñn.	\cap	2	
MENOMINEE	Located in:	Corner C	ode #			:	N S A	3 1 1		Ş	
(County)	Located in:	Content	Joue #			i		32	တီ 🥇	⊃ ≒	
1. Public Land Survey	T <u>38N</u> R_ T R_ T R_ T R_		H-07				OF DECIS	2000 M	æ 55	RECEIVED FOR RECORD	
Property Controlling in Section Miscellaneous Property in Sec.					Reg	jister	of De			File Nu	mber
4. Lot No, Reco	orded Plat										
5. Private Claims	Adda Hat				1 A E	C	D E	F G	Н		
					2 - 6	;	- 5-	-4-	— ġ	<u> </u>	i-
• ,		_			3						
i, William Lenca requirements of P.A. 74, Michig conformance with regulations an United States Department of the that the corner points mentione Board of Land Surveyors or t recovered, found as expressed t	gan P.A. of 1970, the corne nd rules therefore as require e Interior, Bureau of Land M ed in lines 3, 4 and 5 above by a Decree of a Court o	er points mention ed in the current r lanagement or by were in conform	ned in lines 1 and 1 manual of survey in: y a decree of a Coul ance with the rules	z above were in structions of the rt of Law and /or of the Michigan	5 — 1 7 — 8 — 1	9	-17	16 	15	1423	13-
NOTE: Not more than 2 co on this certificate.	rmers, all in the same tow	n and range, m	nay be recorded		9 3	0	-29	28	—27— 	26-	25
					11 —	1——	-32		34	35	-36-
A. Description of original m	nonument and accessori	ies and/or sub	sequent restorati	on:	13					<u>-11</u>	
1849: Original Surve evidence for th 1995: Plat of Survey	ey by James H. Mullett his corner has been des by William Lenca, RL	trough by con-	nty road improv	emenis.							inal
	widence found and/or mo	San Bast W	Toot County Pos	d and in line wi	th anci	ent fe	nces]	North -	South	as note	ed in
my 1005 Dist of Survey	pike in the centerline of y. This position fits reaccepted as the best available.	asonabiy weli	with a GLO Te	rram can to a sv	wamp e	uge 4	chair	ns East	, fits e	xisting	lines

Set 5/8" x 24" Iron Rod/3-1/4" dia. Alum. cap stamped for corner location 6" below gravel road:

33.44 feet South 30" dia. Apple Scr. NBT 46.95 feet S710W 9" dia. Elm 29.18 feet N050W S.E. Corner of Electric Box South 19.7 feet Metal Survey Sign Post Nothing else nearby

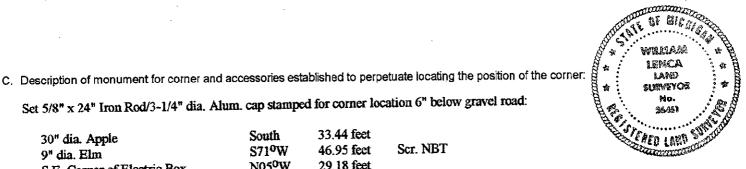

NOTE: All bearings are magnetic bearings. All distances are measured with steel tape. Distances to trees are to nail in side of tree.

Signed by Allan Jaula
Surveyor's Michigan License No

Dec. 23, 1998