

APR 06 1999

Approved by Menominee County
Land Survey Remonumentation
Peer Group Under Act 345 Of
P.A. Of 1980 On 12/30 1998
Mr. Davis RLS
Chairman

SECTION

LAND CORNER RECORDATION CERTIFICATE
Filing Requirement of Act 74, Mich. P.A. 1970

For corners in

MENOMINEE
(County)

Located in:


Corner Code #

- | | | | |
|------------------------------------|-------|-------------------|-------------|
| 1. Public Land Survey | | <u>T38N R 28W</u> | <u>I-09</u> |
| | | T ___ R ___ | _____ |
| | | T ___ R ___ | _____ |
| | | T ___ R ___ | _____ |
| 2. Property Controlling in Section | S ___ | T ___ R ___ | _____ |
| | S ___ | T ___ R ___ | _____ |
| 3. Miscellaneous Property in Sec. | S ___ | T ___ R ___ | _____ |
| | S ___ | T ___ R ___ | _____ |

RECEIVED FOR RECORD
99 JAN -6 AM 8:56
PAGE # 738 BK 5
BARBARA MORRISON
REGISTER OF DEEDS
MENOMINEE MI 49869
Register of Deeds Stamp & File Number

4. Lot No. _____, Recorded Plat _____
5. Private Claims _____

I, William Lenca, in a field survey on Feb. 17, 1998 do hereby state that under requirements of P.A. 74, Michigan P.A. of 1970, the corner points mentioned in lines 1 and 2 above were in conformance with regulations and rules therefore as required in the current manual of survey instructions of the United States Department of the Interior, Bureau of Land Management or by a decree of a Court of Law and /or that the corner points mentioned in lines 3, 4 and 5 above were in conformance with the rules of the Michigan Board of Land Surveyors or by a Decree of a Court of Law; established, re-established, monumented, recovered, found as expressed below:

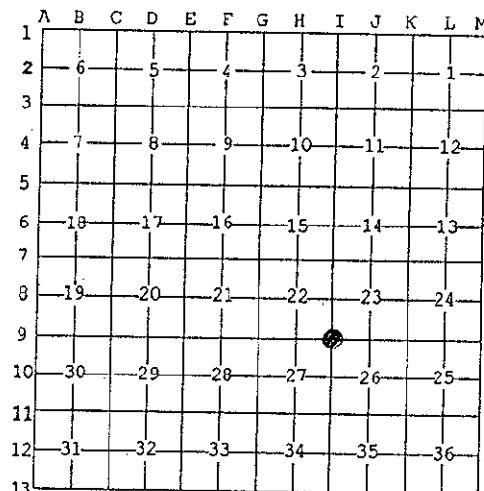

NOTE: Not more than 2 corners, all in the same town and range, may be recorded on this certificate.

A. Description of original monument and accessories and/or subsequent restoration:

- 1849: Original Survey by James H. Mullett - B.T.'s - Birch, 10" - N69°W - 60 lks.; Hemlock, 10" - S58°W - 65 lks. All original evidence for this corner has been destroyed by logging activities.
1964: L.C.R.C. Number 495 by Neal Sperhake, RLS 7876, states he set this corner by proportionate measurement. - Set Galvanized Iron Pipe, 3' long, 1" in diameter, with aluminum cap denoted as "KIMBERLY-CLARK CORP. T38N 22, 23, 26, 27 R28W SPERHAKE RLS 7876 9-9-64." TIES: Elm, 16" - N61°W - 54 lks.; B. Ash, 5" - N45°E - 78 lks.; Elm, 7" - S66°E - 17.5 lks.; Elm, 8" - S41°W - 24.5 lks. (No B.T.'s evident)

B. Description of corner evidence found and/or method applied in restoring or reestablishing corner:

We found a 1-1/4" Iron Pipe with a 4" Aluminum cap marked "KIMBERLY-CLARK CORP. SPERHAKE RLS 7876 9-9-64" as indicated in Land Corner Recordation Certificate Number 495. Distances to corners 1/2 mile North and 1/2 mile South match well with Sperhake record distances. We were unable to find the fence corner which Sperhake used for the 1/4 Corner between Sections 22 and 27. This position has been used for many years, matches well with the centerline of a county road to the South, fits reasonably well with GLO Terrain calls to swamp edges South & West, and is accepted as the best available evidence of the position of the original corner.

C. Description of monument for corner and accessories established to perpetuate locating the position of the corner:

Accepted existing 1-1/4" Iron Pipe/4" dia. Alum. cap stamped for corner location:

6" dia. Cedar	N24°E	42.66 feet	Scr. NBT
7" dia. White Ash	East	22.95 feet	Scr. NBT
8" dia. White Ash	S23°W	8.73 feet	Scr. NBT
10" dia. White Spruce	N83°W	54.07 feet	Scr. NBT
Metal Survey Sign Post	North	0.9 feet	

NOTE: All bearings are magnetic bearings. All distances are measured with steel tape. Distances to trees are to nail in side of tree.

Signed by William Lenca
Surveyor's Michigan License No. 26461

Date Dec. 23, 1998

