

APR 06 1999

Approved by Menominee County
Land Survey Remonumentation
Peer Group Under Act 345 Of
P.A. Of 1990 On 12/30, 1998
Neil Davis PLS
Chairman

SECTION

LAND CORNER RECORDATION CERTIFICATE
Filing Requirement of Act 74, Mich. P.A. 1970

For corners in

MENOMINEE
(County)

Located In:

Corner Code #


1. Public Land Survey		<u>T38N R 28W</u>	<u>I-10</u>
		T ___ R ___	_____
		T ___ R ___	_____
		T ___ R ___	_____
2. Property Controlling in Section	S ___	T ___ R ___	_____
	S ___	T ___ R ___	_____
3. Miscellaneous Property in Sec.	S ___	T ___ R ___	_____
	S ___	T ___ R ___	_____

RECEIVED FOR RECORD
99 JAN - 6 AM 8:56
PAGE # 739 BKS
BARBARA MORRISON
REGISTER OF DEEDS
MENOMINEE, MI 49855
Register of Deeds Stamp & File Number

4. Lot No. _____, Recorded Plat _____
5. Private Claims _____

I, William Lenca, in a field survey on Nov., 1998 do hereby state that under requirements of P.A. 74, Michigan P.A. of 1970, the corner points mentioned in lines 1 and 2 above were in conformance with regulations and rules therefore as required in the current manual of survey instructions of the United States Department of the Interior, Bureau of Land Management or by a decree of a Court of Law and for that the corner points mentioned in lines 3, 4 and 5 above were in conformance with the rules of the Michigan Board of Land Surveyors or by a Decree of a Court of Law; established, re-established, monumented, recovered, found as expressed below:

NOTE: Not more than 2 corners, all in the same town and range, may be recorded on this certificate.

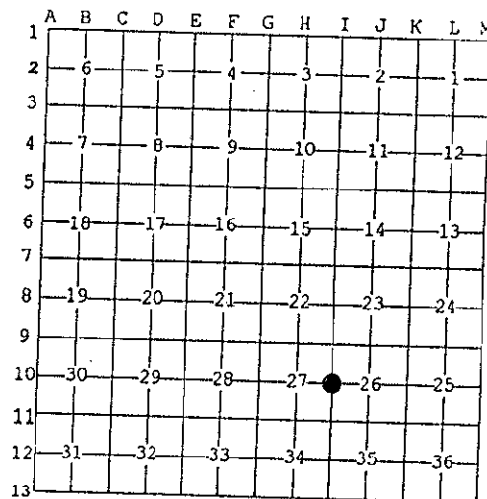

A. Description of original monument and accessories and/or subsequent restoration:

- 1849: Original Survey by James H. Mullett - B.T.'s - Sugar, 10" - N60°E - 52 lks.; Hemlock, 8" - S60°W - 52 lks. All original evidence for this corner has been destroyed by county road improvements.
- 1964: L.C.R.C. No. 495 (Vol 3) by Neal Spherhake refers to this corner in positioning the NE Corner of Section 27. He describes the corner as a fence line 1/2 mile south.

B. Description of corner evidence found and/or method applied in restoring or reestablishing corner:

We set this corner in line with the centerline of a North - South County Road and in line with an ancient fence line running West. Our measured distance from this corner to the NE Corner of Section 27, T38N-R28W matches Spherhake's distance of 2635.05 feet. We accepted this location as the best available evidence of the position of the original corner.

C. Description of monument for corner and accessories established to perpetuate locating the position of the corner:

Set 5/8" x 24" Iron Rod/3-1/4" dia. Alum. cap stamped for corner location:

8" dia. White Pine ("X" cut in upper & lower blazes)	N53°E	57.29 feet	
7" dia. Spruce ("X" cut in upper & lower blazes)	S52°E	72.50 feet	
5/8" x 24" Iron Rod/2" dia. Alum. cap marked "WITNESS MARKER"	S56°W	79.90 feet	1' N. of 8" Scotch Pine
5/8" x 24" Iron Rod/2" dia. Alum. cap marked "WITNESS MARKER"	N32°W	68.28 feet	1' E. of Fc. Post
Metal Survey Sign Post	East	33.8 feet	

NOTE: All bearings are magnetic bearings. All distances are measured with steel tape. Distances to trees are to nail in side of tree.

Signed by William Lenca
Surveyor's Michigan License No. 26461

Date Dec. 29, 1998

