

# SURVEY & REMONUMENTATION

JAN 09 2001

## SECTION

## LAND CORNER RECORDATION CERTIFICATE

Filing Requirement of Act 74, Mich. P.A. 1970

Approved by Menominee County  
Land Survey Remonumentation  
Peer Group Under Act 345 of  
P.A. Of 1990 On 12/22, 2000  
ME DAVIS RLS  
Chairman

For corners in  
MENOMINEE

(County)

Located In:

Corner Code #

1. Public Land Survey	T <u>39N</u>	R <u>25W</u>	G-09
	T _____	R _____	_____
	T _____	R _____	_____
	T _____	R _____	_____
2. Property Controlling in Section	S _____	T _____	R _____
	S _____	T _____	R _____
3. Miscellaneous Property in Sec.	S _____	T _____	R _____
	S _____	T _____	R _____

BR. 6 Pg. 219


RECEIVED FOR RECORD  
28 DEC 2000 2:31:31 PM  
BARBARA MORRISON  
REGISTER OF DEEDS  
MENOMINEE, MI 49858

Register of Deeds Stamp & File Number

4. Lot No. \_\_\_\_\_, Recorded Plat \_\_\_\_\_  
5. Private Claims \_\_\_\_\_

I, William Lenca, in a field survey on Aug. 09, 1900 do hereby state that under requirements of P.A. 74, Michigan P.A. of 1970, the corner points mentioned in lines 1 and 2 above were in conformance with regulations and rules therefore as required in the current manual of survey instructions of the United States Department of the Interior, Bureau of Land Management or by a decree of a Court of Law and /or that the corner points mentioned in lines 3, 4 and 5 above were in conformance with the rules of the Michigan Board of Land Surveyors or by a Decree of a Court of Law; established, re-established, monumented, recovered, found as expressed below:

**NOTE:** Not more than 2 corners, all in the same town and range, may be recorded on this certificate.

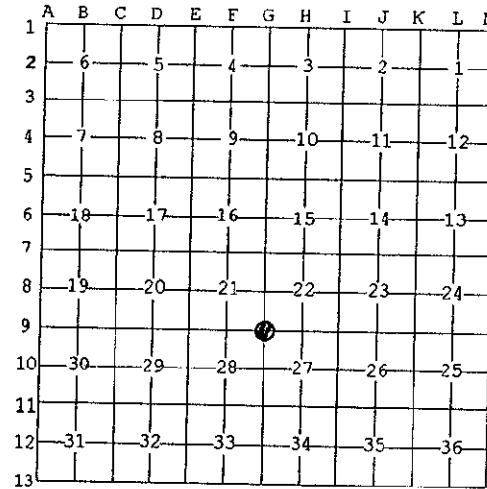

**A. Description of original monument and accessories and/or subsequent restoration:**

1848: Original Survey by George E. Adair - B.T.'s - Cedar, 8" - N74°W - 30lks.; Cedar, 12" - S73°E - 03 lks. All original evidence for this corner has been destroyed by logging activities.


**B. Description of corner evidence found and/or method applied in restoring or reestablishing corner:**

We recovered a very old squared wood post next to a channel iron in a location that matches well with measurements to corners 1 mile East (5265' Meas. - GLO = 5280') and 1 mile South (5207' Meas. - GLO = 5210') and with a GLO Terrain call to a swamp edge 3.44 chains West. There was also evidence of an old survey traverse tying into this post, indicating that it had been used in other surveys. We accepted the position of the old wood post as the best available evidence of the position of the original corner.

**C. Description of monument for corner and accessories established to perpetuate locating the position of the corner:**

Set 3/4" dia. x 4' long aluminum rod/3-1/4" dia. Alum. cap stamped for corner.

10" dia. Cedar	N78°E	18.39 feet	Scr. NBT
8" dia. Cedar	S22°E	12.31 feet	Scr. NBT
8" dia. Cedar	S78°W	9.25 feet	Scr. NBT
7" dia. Cedar	N14°W	15.74 feet	Scr. NBT
Metal Survey Sign Post	North	1.0 feet	

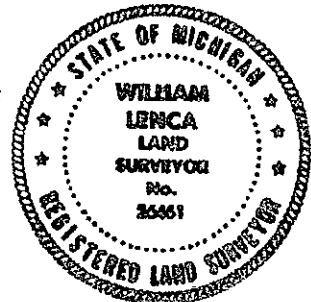

**NOTE:** All bearings are magnetic bearings. All distances are measured with steel tape. Distances to trees are to nail in side of tree.

Signed by William Lenca  
Surveyor's Michigan License No. 26461

Date Aug. 19, 2000