

1993

COMMISSION

LAND CORNER RECORDATION CERTIFICATE
Filing Requirement of Act 74, Mich. P.A. 1970

Approved by Menominee County Land Survey Remonumentation Peer Group Under Act 345 Of P.A. Of 1990 On Dec 28 1993
W. Alan Jones Chairman

For corners in MENOMINEE (County)

Located In:

Corner Code #

Table with 3 columns: Description (Public Land Survey, Property Controlling in Section, Miscellaneous Property in Sec.), Bearings (T, S), Distances (39N, R.25W, etc.), and Corner Code # (G-11 & G-12).

RECEIVED FOR RECORD
93 DEC 29 PM 3:55
PAGE # 44, BE 4
BARBARA MORRISON
REGISTER OF DEEDS
MENOMINEE, MI 49858

Register of Deeds Stamp & File Number

4. Lot No. Recorded Plat
5. Private Claims [G-11] NW COR SEC 34 [G-12] W1/4 COR SEC 34

Grid table with columns A-L and rows 1-13, containing numbers 1-36.

I, M. P. DAVIS, in a field survey on AUGUST, 1993, do hereby certify that under requirements of P.A. 74, Michigan P.A. of 1970, the corner points mentioned in lines 1 and 2 above were in conformance with regulations and rules therefore as required in the current manual of survey instructions of the United States Department of the Interior, Bureau of Land Management or by a decree of a Court of Law and/or that the corner points mentioned in lines 3, 4 and 5 above were in conformance with the rules of the Michigan Board of Land Surveyors or by a Decree of a Court of Law; established, re-established, monumented, re-monumented, recovered, found as expressed below:


NOTE: Not more than 4 corners, all in the same town and range, may be recorded on this certificate.

A. Description of original monument and accessories and/or subsequent restoration:

- [G 11] WOOD POST - G.E. ADAIR 1852 (CEDAR 10" - S30°E 0.14 CHAINS) (CEDAR 10" - N38°W 0.45 CHAINS)
[G 12] WOOD POST - G.E. ADAIR 1852 (SUGAR MAPLE 11" - S28°W 0.57 CHAINS) (BEECH 12" - N24°E 0.20 CHAINS)

B. Description of corner evidence found and/or method applied in restoring or reestablishing corner:

- [G 11] NO EVIDENCE OF ORIGINAL CORNER MONUMENTATION FOUND. FOUND SQUARED WOOD POST SET BY LOCAL RESIDENT AND LAND OWNER MR. NORBERT BELLEFEUIL. HIS TESTIMONY INCLUDED THE SETTING OF A .22 CALIBER GUN BARREL FOR THE CORNER POSITION BUT NO EVIDENCE WAS FOUND. HIS TESTIMONY ALSO REVEALED THAT NEW SQUARED POST WAS PLACED AT POSITION OF OLD WOOD POST SINCE ROTTED. ACCEPTED THIS NEW WOOD POST AS A CAREFUL AND FAITHFUL REESTABLISHMENT OF THE POSITION OF THE ORIGINAL CORNER.
[G 12] FOUND 1" IRON PIPE, ESTABLISHED BY UNKNOWN. FALLS IN CENTER LINE OF GRAVEL DRIVE. LOCAL RESIDENT AND LONG TIME LAND OWNER MR. NORBERT BELLEFEUIL CLAIMS AT ONE TIME, A EAST AND WEST FENCE JOINED AT THIS POINT, SINCE REMOVED. ACCEPTED THIS 1" IRON PIPE AS A CAREFUL AND FAITHFUL REESTABLISHMENT OF THE POSITION OF THE ORIGINAL CORNER.

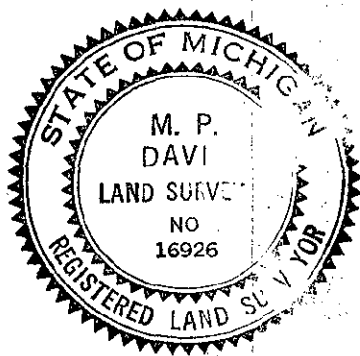

C. Description of monument for corner and accessories established to perpetuate locating the position of the corner:

- [G 11] REPLACED CEDAR POST W/A BERNTSEN AINB30 ALUMINUM MONUMENT W/A 3 1/4" CAP STAMPED TO ID THE CORNER POSITION. CEDAR 8" N20°W 9.57', CEDAR 12" N29°E 36.62', CEDAR 6" S78°E 27.22', TAMARACK 9" S58°W 11.45', STEEL SIGN POST WEST 2.27 (TO FACE)
[G 12] REPLACED 1" IRON PIPE W/A BERNTSEN AINB30 ALUMN MONUMENT W/A 3 1/4" CAP STAMPED TO ID THE CORNER POSITION. POWER POLE N37°W 101.11' (TO FACE), SW BUILDING CORNER N33°E 72.45', SPRUCE 14" S15°E 59.72', WITNESS IRON W/CAP S63°W 20.42'

NOTE: BEARINGS TO REFERENCE OBJECTS ARE MAGNETIC & DISTANCES ARE TO A NAIL IN THE CENTER OF THE OBJECT UNLESS OTHERWISE NOTED.

Signed by M.P. Davis Date 12/27/93
Surveyor's Michigan License No. 16926

See Reverse Side