

1993

COMMISSION

Approved by Menominee County  
Land Survey Remonumentation  
Peer Group Under Act 345 Of  
P.A. Of 1990 On Dec. 28, 1993  
William J. Davis  
Chairman

LAND CORNER RECORDATION CERTIFICATE  
Filing Requirement of Act 74, Mich. P.A. 1970

For corners in

MENOMINEE  
(County)

Located In:

Corner Code ##

1. Public Land Survey	T <u>39N</u> R <u>25W</u>	<u>G-11 &amp; G-12</u>
	T _____ R _____	_____
	T _____ R _____	_____
2. Property Controlling In Section	S _____ T _____ R _____	_____
	S _____ T _____ R _____	_____
3. Miscellaneous Property in Sec.	S _____ T _____ R _____	_____
	S _____ T _____ R _____	_____

RECEIVED FOR RECORD  
93 DEC 29 PM 3:55  
PAGE # 44 PL. 4  
BARBARA MORRISON  
REGISTER OF DEEDS  
MENOMINEE MI 49858  
Register of Deeds Stamp & File Number

4. Lot No. \_\_\_\_\_, Recorded Plat \_\_\_\_\_  
5. Private Claims \_\_\_\_\_  
[G-11] NW COR SEC 34 [G-12] W1/4 COR SEC 34

A	B	C	D	E	F	G	H	I	J	K	L	M
2	6	5	4	3	2	1						
3												
4	7	8	9	10	11	12						
5												
6	18	17	16	15	14	13						
7												
8	19	20	21	22	23	24						
9												
10	30	29	28	27	26	25						
11												
12	31	32	33	34	35	36						
13												

I, M. P. DAVIS, in a field survey on AUGUST, 19 93, do hereby certify that under requirements of P.A. 74, Michigan P.A. of 1970, the corner points mentioned in lines 1 and 2 above were in conformance with regulations and rules therefore as required in the current manual of survey instructions of the United States Department of the Interior, Bureau of Land Management or by a decree of a Court of Law and/or that the corner points mentioned in lines 3, 4 and 5 above were in conformance with the rules of the Michigan Board of Land Surveyors or by a Decree of a Court of Law; established, re-established, monumented, re-monumented, recovered, found as expressed below:

NOTE: Not more than 4 corners, all in the same town and range, may be recorded on this certificate.

A. Description of original monument and accessories and/or subsequent restoration:

[ G 11 ] WOOD POST - G.E. ADAIR 1852  
(CEDAR 10" - S30°E 0.14 CHAINS) (CEDAR 10" - N36°W 0.45 CHAINS)

[ G 12 ] WOOD POST - G.E. ADAIR 1852  
(SUGAR MAPLE 11" - S28°W 0.57 CHAINS) (BEECH 12" - N24°E 0.20 CHAINS)

B. Description of corner evidence found and/or method applied in restoring or reestablishing corner:

[ G 11 ] NO EVIDENCE OF ORIGINAL CORNER MONUMENTATION FOUND. FOUND SQUARED WOOD POST SET BY LOCAL RESIDENT AND LAND OWNER MR. NORBERT BELLEFEUIL. HIS TESTIMONY INCLUDED THE SETTING OF A .22 CALIBER GUN BARREL FOR THE CORNER POSITION BUT NO EVIDENCE WAS FOUND. HIS TESTIMONY ALSO REVEALED THAT NEW SQUARED POST WAS PLACED AT POSITION OF OLD WOOD POST SINCE ROTTED. ACCEPTED THIS NEW WOOD POST AS A CAREFUL AND FAITHFUL REESTABLISHMENT OF THE POSITION OF THE ORIGINAL CORNER.

[ G 12 ] FOUND 1" IRON PIPE, ESTABLISHED BY UNKNOWN. FALLS IN CENTER LINE OF GRAVEL DRIVE. LOCAL RESIDENT AND LONG TIME LAND OWNER MR. NORBERT BELLEFEUIL CLAIMS AT ONE TIME, A EAST AND WEST FENCE JOINED AT THIS POINT, SINCE REMOVED. ACCEPTED THIS 1" IRON PIPE AS A CAREFUL AND FAITHFUL REESTABLISHMENT OF THE POSITION OF THE ORIGINAL CORNER.


C. Description of monument for corner and accessories established to perpetuate locating the position of the corner:

[ G 11 ] REPLACED CEDAR POST W/A BERNTSEN A1NB30 ALUMINUM MONUMENT W/A 3 1/4" CAP STAMPED TO ID THE CORNER POSITION.  
CEDAR 8" CEDAR 12" CEDAR 6" TAMARACK 9" STEEL SIGN POST  
N20°W N29°E S78°E S58°W WEST  
9.57' 36.62' 27.22' 11.45' 2.27 (TO FACE)

[ G 12 ] REPLACED 1" IRON PIPE W/A BERNTSEN A1NB30 ALUMN MONUMENT W/A 3 1/4" CAP STAMPED TO ID THE CORNER POSITION.  
POWER POLE SW BUILDING CORNER SPRUCE 14" WITNESS IRON W/CAP  
N37°W N33°E S15°E S63°W  
101.11' (TO FACE) 72.45' 59.72' 20.42'

NOTE: BEARINGS TO REFERENCE OBJECTS ARE MAGNETIC & DISTANCES ARE TO A NAIL IN THE CENTER OF THE OBJECT UNLESS OTHERWISE NOTED.

Signed by M.P. Davis Date 12/27/93  
Surveyor's Michigan License No. 16926

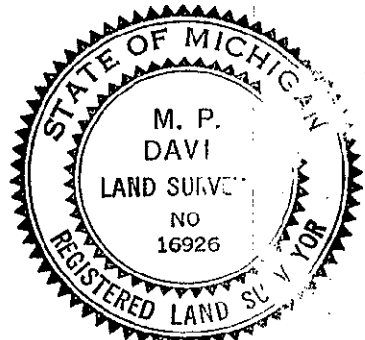

See Reverse Side