

1993

COMMISSION

LAND CORNER RECORDATION CERTIFICATE
Filing Requirement of Act 74, Mich. P.A. 1970

Approved by Menominee County
Land Survey Reestablishment
Peer Group Under Act 305 of
P.A. of 1990 on Dec 28 1993
William J. ... Chairman

For corners in
MENOMINEE
(County)

Located In:

Corner Code #

Table with 3 columns: Description (Public Land Survey, Property Controlling, etc.), Township/Range (T 39N R 25W, etc.), and Corner Code (G-13 & H-13).

PAGE # 46, Bk. 4
BARBARA MORRISON
REGISTER OF DEEDS
MENOMINEE, MI 49858

93 DEC 29 PM 3:55

RECEIVED FOR RECORD

Register of Deeds Stamp & File Number

4. Lot No. ... Recorded Plat ...
5. Private Claims
[G-13] SW COR SEC 34 [H-13] S1/4 COR SEC 34

Grid table with columns A-M and rows 2-13, containing numbers 1-36.

I, M.P. DAVIS, in a field survey on AUGUST, 19 93, do hereby certify that under requirements of P.A. 74, Michigan P.A. of 1970, the corner points mentioned in lines 1 and 2 above were in conformance with regulations and rules therefore as required in the current manual of survey instructions of the United States Department of the Interior, Bureau of Land Management or by a decree of a Court of Law and/or that the corner points mentioned in lines 3, 4 and 5 above were in conformance with the rules of the Michigan Board of Land Surveyors or by a Decree of a Court of Law; established, re-established, monumented, re-monumented, recovered, found as expressed below:


NOTE: Not more than 4 corners, all in the same town and range, may be recorded on this certificate.

A. Description of original monument and accessories and/or subsequent restoration:
[G-13] WOOD POST - J.H. MULLETT, D.S. 1848 (CEDAR 10" - N24°W 0.18 CHAINS)(CEDAR 12" - N38°E 0.25 CHAINS)
WOOD POST - G.E. ADAIR, D.S. 1852 (CEDAR 10" - S17.5°W 0.30 CHAINS)(CEDAR 10" - S45°E 0.35 CHAINS)

[H-13] WOOD POST - G.E. ADAIR, D.S. 1852 (LYNN 10" - N31°W 0.23 CHAINS)(HEMLOCK 12" - N50°E 0.41 CORNER IDENTIFIED AND REPLACED WITH IRON IN 1930 BY M.S. McNABB (STAKE IN ROAD SOUTH), (BT STAKE - N45°W - 33.0'), (FENCE POST - NW 28.6')

B. Description of corner evidence found and/or method applied in restoring or reestablishing corner:
[G-13] NO EVIDENCE OF ORIGINAL CORNER MONUMENTATION FOUND. FOUND SQUARED WOOD POST SCRIBED 3,4,33,34. ESTABLISHED BY UNKNOWN. ACCEPTED AS A CAREFUL AND FAITHFUL REESTABLISHMENT OF THE POSITION OF THE ORIGINAL CORNER.

[H-13] NO EVIDENCE OF ORIGINAL MONUMENTATION FOUND. FOUND 1" SOLID IRON SET BY M.S. McNABB FROM RETRACEMENT IN 1930. McNABB'S WITNESSES: STAKE IN ROAD SOUTH (STAKE GONE - ROAD BED REMAINS), FENCE WEST (GONE), BT STAKE - N45°W. 33.0 FEET (GONE), FENCE POST - NW 28.6 FEET (GONE) ACCEPTED AS A CAREFUL AND FAITHFUL REESTABLISHMENT OF THE POSITION OF THE ORIGINAL CORNER.

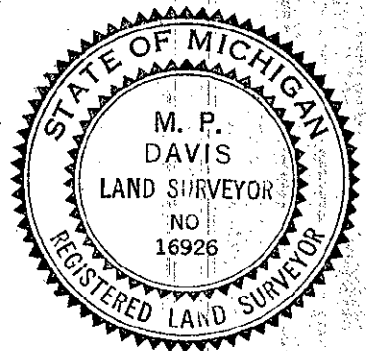

C. Description of monument for corner and accessories established to perpetuate locating the position of the corner:

[G-13] REPLACED WOOD POST W/A BERNTSEN A1NB30 ALUMN MONUMENT W/A CAP STAMPED TO ID THE CORNER POSITION.
CEDAR 9" SPRUCE 12" CEDAR 7" STEEL SIGN POST SPRUCE 7"
N12°W N60°E S52°E SOUTH S65°W
16.90' 21.22' 56.33' 3.03 (TO FACE) 52.18'

[H-13] REPLACED 1" IRON W/A BERNTSEN A1NB30 ALUMN MONUMENT W/A CAP STAMPED TO ID THE CORNER POSITION.
BALSAM 8" STEEL SIGN POST MAPLE 6" CEDAR 12" CEDAR 11"
N66°W N38°W N39°E S26°E S58°W
44.80' 3.06 (TO FACE) 18.79' 49.47' 32.42'

NOTE: BEARINGS TO OBJECTS ARE MAGNETIC & DISTANCES TO OBJECTS ARE TO A NAIL IN THE CENTER OF THE OBJECT UNLESS OTHERWISE NOTED.

Signed by M.P. Davis Date 12/27/93

Surveyor's Michigan License No. 16926