

Approved by Menominee County  
 Land Survey Remonumentation  
 Peer Group Under Act 345 Of  
 P.A. of 1990 On 9/25 1999  
William Lenca  
 Chairman

LAND CORNER RECORDATION CERTIFICATE  
 Filing Requirement of Act 74, Mich. P.A. 1970

For corners in

MENOMINEE  
 (County)

Located In: Corner Code #

- |                                    |  |               |
|------------------------------------|--|---------------|
| 1. Public Land Survey              | T <u>40</u> N R <u>25</u> W            | <u>113</u>    |
|                                    | T <u>39</u> R <u>25</u>                | <u>I-01</u> ✓ |
|                                    | T <u>   </u> R <u>   </u>              | <u>   </u>    |
| 2. Property Controlling in Section | S <u>   </u> T <u>   </u> R <u>   </u> | <u>   </u>    |
|                                    | S <u>   </u> T <u>   </u> R <u>   </u> | <u>   </u>    |
| 3. Miscellaneous Property in Sec.  | S <u>   </u> T <u>   </u> R <u>   </u> | <u>   </u>    |
|                                    | S <u>   </u> T <u>   </u> R <u>   </u> | <u>   </u>    |

RECEIVED FOR RECORD  
 96 OCT -7 PM 3:24  
 PAGE # 342 BK 4  
 LAND SURVEY COMMISSION  
 REGISTERED SURVEYORS  
 REGISTERED OFFICE

Register of Deeds Stamp & File Number

4. Lot No. \_\_\_\_\_, Recorded Plat \_\_\_\_\_  
 5. Private Claims \_\_\_\_\_  
 (SAME AS CORNER I01 T39N-R25W) ✓

I, William Lenca, in a field survey on Aug. 12, 1996 do hereby state that under requirements of P.A. 74, Michigan P.A. of 1970, the corner points mentioned in lines 1 and 2 above were in conformance with regulations and rules therefore as required in the current manual of survey instructions of the United States Department of the Interior, Bureau of Land Management or by a decree of a Court of Law and/or that the corner points mentioned in lines 3, 4 and 5 above were in conformance with the rules of the Michigan Board of Land Surveyors or by a Decree of a Court of Law; established, re-established, monumented, recovered, found as expressed below:

NOTE: Not more than 2 corners, all in the same town and range, may be recorded on this certificate.

1	A	B	C	D	E	F	G	H	I	J	K	L	M
2	6		5		4		3		2		1		
3													
4	7		8		9		10		11		12		
5													
6	18		17		16		15		14		13		
7													
8	19		20		21		22		23		24		
9													
10	30		29		28		27		26		25		
11													
12	31		32		33		34		35		36		
13													

A. Description of original monument and accessories and/or subsequent restoration:


1848: Original Survey (Township Boundary) by James H. Mullett - B.T.'s - Cedar, 12" - N62°E - 05 lks; Cedar, 10" - N29°W - 11 links. All original evidence for this corner has been destroyed by county road improvements.

B. Description of corner evidence found and/or method applied in restoring or reestablishing corner:

We found a 5/8 inch diameter iron pipe on the West side of a North - South gravel road and in line with old fences running East and West. We also found 2 trees which were blazed and scribed "NBT". This corner fit well with existing lines of occupation and has been used by other surveyors, and is accepted as the best available evidence of the position of the original corner.

C. Description of monument for corner and accessories established to perpetuate locating the position of the corner:

Set 5/8" x 24" Iron Rod/3-1/4" dia. Alum. cap stamped for corner location:

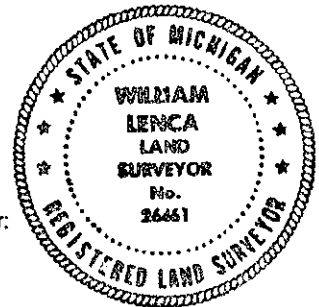

- |   |       |            |                       |
|---|-------|------------|-----------------------|
| 9" dia. Cedar   | N56°E | 40.01 feet | Scr. NBT              |
| 5" dia. Cedar   | S51°E | 31.08 feet | Scr. NBT              |
| Twin 6" dia. Cedar  | N44°W | 45.01 feet | Scr. NBT              |
| 5/8" x 24" Iron Rod/2" dia. Alum. cap marked "WITNESS MARKER" | S45°W | 39.40 feet | 0.7' W. of 10" Poplar |
| Metal Survey Sign Post  | N90°W | 22.2 feet  |                       |

NOTE: All bearings are magnetic bearings. All distances are measured with steel tape. Distances to trees are to nail in side of tree.

Signed by William Lenca  
 Surveyor's Michigan License No. 26461

Date Aug. 30, 1996