

SURVEY & REMONUMENTATION

APR 24 1995

COMMISSION

LAND CORNER RECORDATION CERTIFICATE Filing Requirement of Act 74, Mich. P.A. 1970

For corners in
MENOMINEE
(County)

Located In: _____ Corner Code # _____

- | | | | |
|------------------------------------|-----------------------------|------------------|-------|
| 1. Public Land Survey | T <u>39 N</u> R <u>25 W</u> | H-3 <u>(I-4)</u> | |
| | T _____ R _____ | _____ | _____ |
| | T _____ R _____ | _____ | _____ |
| | T _____ R _____ | _____ | _____ |
| 2. Property Controlling in Section | S _____ T _____ R _____ | _____ | _____ |
| | S _____ T _____ R _____ | _____ | _____ |
| 3. Miscellaneous Property in Sec. | S _____ T _____ R _____ | _____ | _____ |
| | S _____ T _____ R _____ | _____ | _____ |

Approved by Menominee County
Land Survey Remonumentation
Four Group Under Act 345 Of
P.A. of 1990 On Dec. 16, 1994

M.P. Davis
Chairman

94 DEC 27 AM 10:45
 PAGE # 150 BK 9
 BARBARA MORRISON
 REGISTER OF DEEDS
 HENOMINEE MI 498358

RECEIVED FOR RECORD

Register of Deeds Stamp & File Number

4. Lot No. _____, Recorded Plat _____
5. Private Claims H-3 [N1/4 COR SEC 10] I-4 [E1/4 COR SEC 10]

	A	B	C	D	E	F	G	H	I	J	K	L	M
2	6	5	4	3	2	1							
3								•					
4	7	8	9	10	11	12							
5													
6	18	17	16	15	14	13							
7													
8	19	20	21	22	23	24							
9													
10	30	29	28	27	26	25							
11													
12	31	32	33	34	35	36							
13													

I, M.P. DAVIS, in a field survey on OCTOBER, 19 94, do hereby certify that under requirements of P.A. 74, Michigan P.A. of 1970, the corner points mentioned in lines 1 and 2 above were in conformance with regulations and rules therefore as required in the current manual of survey instructions of the United States Department of the Interior, Bureau of Land Management or by a decree of a Court of Law and/or that the corner points mentioned in lines 3, 4 and 5 above were in conformance with the rules of the Michigan Board of Land Surveyors or by a Decree of a Court of Law; established, re-established, monumented, re-monumented, recovered, found as expressed below:

NOTE: Not more than 4 corners, all in the same town and range, may be recorded on this certificate.

A. Description of original monument and accessories and/or subsequent restoration:


H-3 [N1/4 COR S.10] G. ADAIR D.S. - 1852 - WOOD POST (CEDAR 08°-N55°E-0.23 CHAINS) (HEMLOCK 22°-S8°W-0.25 CHAINS)
NO RECORD EVIDENCE OF SUBSEQUENT CORNER RECOVERY OR MONUMENTATION.

I-4 [E1/4 COR S.10] G. ADAIR D.S.- 1852 - WOOD POST (LYNN 10°-N34°E-0.22 CHAINS) (SUGAR 12°-S61°W-0.17 CHAINS)
NO RECORD EVIDENCE OF SUBSEQUENT CORNER RECOVERY OR MONUMENTATION.

B. Description of corner evidence found and/or method applied in restoring or reestablishing corner:

H-3 [N1/4 COR S.10] NO CORNER EVIDENCE FOUND AS ALL EVIDENCE OF CORNER POSITION APPEARS TO HAVE BEEN DESTROYED DURING ROAD CONSTRUCTION. RESTORED CORNER POSITION FROM TESTIMONY OF MR. JOHN KUTHA, PROPERTY OWNER AND LIFELONG RESIDENT OF THE AREA WHO KNEW OF THE EXISTANCE OF AN IRON PIN MONUMENT PRIOR TO THE RECONSTRUCTION OF THE E & W COUNTY ROAD. THIS POSITION FALLS AT THE APPROX C/L INTERSECTION OF COUNTY ROADS E, W, & S. ACCEPTED THIS LOCATION AS BEING THE BEST AVAILABLE EVIDENCE AS TO THE POSITION OF THE ORIGINAL CORNER.

I-4 [E1/4 COR S.10] NO CORNER EVIDENCE FOUND AS ALL EVIDENCE OF CORNER POSITION APPEARS TO HAVE BEEN DESTROYED DURING ROAD CONSTRUCTION. RESET CORNER MONUMENT AT MIDPOINT BETWEEN SECTION CORNERS N & S.

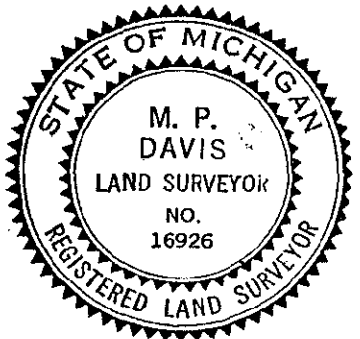

C. Description of monument for corner and accessories established to perpetuate localing the position of the corner:

H-3 SET INSIDE A MON BOX A 5/8" X 18" REBAR W/A 3-1/4" ALUMN CAP STAMPED TO ID THE CORNER POSITION.

TAMARACK 10"	SURVEY MONUMENT SIGN POST	TELEPHONE JNC. BOX POST	POWER POLE
N63°E	S24°E	N40°W	S44°W
93.20'	29.02' (TO FACE)	43.90' (TO FACE)	42.16' (TO FACE)

I-4 SET INSIDE A MON BOX A 5/8" X 18" REBAR W/A 3-1/4" ALUMN CAP STAMPED TO ID THE CORNER POSITION.

HENLOCK 5"	BALSAM 5"	SURVEY MONUMENT SIGN POST	C/L N & S CO. RD.
S70°W	N65°W	EAST	EAST
56.18'	53.24'	23.31' (TO FACE)	2.00'

NOTE: BEARINGS TO REFERENCE OBJECTS ARE MAGNETIC & DISTANCES ARE TO A NAIL IN THE CENTER OF THE OBJECT, UNLESS OTHERWISE NOTED.

Signed by M.P. Davis Date 12/9/94
 Surveyor's Michigan License No. 16926

150