

REVISION

1993

COMMISSION

LAND CORNER RECORDATION CERTIFICATE
Filing Requirement of Act 74, Mich. P.A. 1970

Approved by Menominee County
Land Survey Reamendment
Peer Group Under Act 345 Of
P.A. Of 1990 On Dec 28, 1993

William J. Janda
Chairman

For corners in
MENOMINEE
(County)

Located In: Corner Code --#

- 1. Public Land Survey T 39N R 25W I-11 & H-11
2. Property Controlling in Section S T R
3. Miscellaneous Property in Sec. S T R

RECEIVED FOR RECORD
93 DEC 29 PM 3:55
PAGE # 47, BK 4
BARBARA MORRISON
REGISTER OF DEEDS
MENOMINEE, MI 49858

Register of Deeds Stamp & File Number

- 4. Lot No. Recorded Plat
5. Private Claims [I-11] NE COR SEC 34 [H-11] N1/4 COR SEC 34

Grid table with columns A-L and rows 1-12. Contains numbers 1-36 and two dots in row 11, column H.

I, M.P. DAVIS, in a field survey on AUGUST, 19 93, do hereby certify that under requirements of P.A. 74, Michigan P.A. of 1970, the corner points mentioned in lines 1 and 2 above were in conformance with regulations and rules therefore as required in the current manual of survey instructions of the United States Department of the Interior, Bureau of Land Management or by a decree of a Court of Law and/or that the corner points mentioned in lines 3, 4 and 5 above were in conformance with the rules of the Michigan Board of Land Surveyors or by a Decree of a Court of Law; established, re-established, monumented, re-monumented, recovered, found as expressed below:


NOTE: Not more than 4 corners, all in the same town and range, may be recorded on this certificate.

A. Description of original monument and accessories and/or subsequent restoration:

- [I 11] WOOD POST - G.E. ADAIR 1852 (CEDAR 10" - N45°E 0.21 CHAINS) (TAMARACK 15" - S24°W 0.16 CHAINS)
[H 11] WOOD POST - G.E. ADAIR 1852 (SPRUCE 7" - NORTH 0.09 CHAINS) (TAMARACK 11" - S21°E 0.24 CHAINS)

B. Description of corner evidence found and/or method applied in restoring or reestablishing corner:

- [I 11] NO EVIDENCE OF ORIGINAL OR SUBSEQUENT CORNER MONUMENTATION FOUND. ESTABLISHED NEW CORNER POSITION FROM ANCIENT E-W OCCUPATION AND COUNTY ROAD IMPROVEMENTS.
[H 11] NO EVIDENCE OF ORIGINAL OR SUBSEQUENT CORNER MONUMENTATION FOUND. ESTABLISHED NEW CORNER POSITION AT MIDPOINT BETWEEN SECTION CORNERS EAST AND WEST.

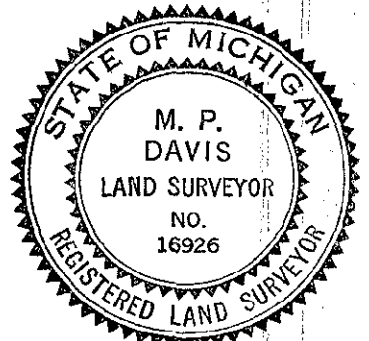

C. Description of monument for corner and accessories established to perpetuate locating the position of the corner:

- [I 11] SET REBAR W/A 3 1/4" ALUMINUM CAP STAMPED TO IDENTIFY THE CORNER POSITION. CEDAR 11" CEDAR 5" POWER POLE STEEL SIGN POST S88°W N42°W N19°E S89°E 45.40' 56.16' 107.84'(TO FACE) 27.85' (TO FACE)
[H 11] SET BERNTSEN A1NB30 ALUMINUM MONUMENT W/A 3 1/4" CAP STAMPED TO IDENTIFY THE CORNER POSITION. CEDAR 8" CEDAR 7" CEDAR 9" CEDAR 5" STEEL SIGN POST N80°W S30°W S56°E N56°E NORTH 4.74' 15.85' 7.97' 21.68' 2.15' (TO FACE)

NOTE: BEARINGS TO REFERENCE OBJECTS ARE MAGNETIC & DISTANCES ARE TO A NAIL IN THE CENTER OF THE OBJECT UNLESS OTHERWISE NOTED.

Signed by M.P. Davis Date 12/27/93
Surveyor's Michigan License No. 16926