

RECORD

1993

COMMISSION

LAND CORNER RECORDATION CERTIFICATE
Filing Requirement of Act 74, Mich. P.A. 1970

Approved by Menominee County
Land Survey Remonumentation
Peer Group Under Act 345 Of
P.A. of 1990 On Dec. 28, 1993
William J. ... Chairman

Form with fields: For corners in MENOMINEE (County), Located In: T 39N R 25W, Corner Code # I-13, I-12. Includes sections for Public Land Survey, Property Controlling in Section, and Miscellaneous Property in Sec.

RECEIVED FOR RECORD
93 DEC 29 PM 3:55
PAGE # 45, Bl. 4
BARBARA MORRISON
REGISTER OF DEEDS
MENOMINEE, MI 49858

Register of Deeds Stamp & File Number

4. Lot No. ... Recorded Plat ...
5. Private Claims [I-13] SE COR SEC 34 [I-12] E1/4 COR SEC 34

Grid table with columns A-M and rows 2-13. Contains numbers 1-36 in a grid pattern.

I, M.P. DAVIS, in a field survey on AUGUST, 19 93, do hereby certify that under requirements of P.A. 74, Michigan P.A. of 1970, the corner points mentioned in lines 1 and 2 above were in conformance with regulations and rules therelore as required in the current manual of survey instructions of the United States Department of the Interior, Bureau of Land Management or by a decree of a Court of Law and/or that the corner points mentioned in lines 3, 4 and 5 above were in conformance with the rules of the Michigan Board of Land Surveyors or by a Decree of a Court of Law; established, re-established, monumented, re-monumented, recovered, found as expressed below:


NOTE: Not more than 4 corners, all in the same town and range, may be recorded on this certificate.

A. Description of original monument and accessories and/or subsequent restoration:
[I 13] WOOD POST - J.H. MULLETT, D.S. 1848 (CEDAR 15 - N36°W 0.12 CHAINS)(CEDAR 10 - N13°E 0.17 CHAINS)
WOOD POST - G.E. ADAIR, D.S. 1852 (CEDAR 10 - S17.5°W 0.30 CHAINS)(CEDAR 10 - S45°E 0.35 CHAINS)
CORNER IDENTIFIED AND REPLACED WITH IRON IN 1930 BY M.S. McNABB
(POPLAR 14 - W. 36.4 FEET)(ELM 3 - 34.5 FEET)(TAMARACK POLE - N45°E 30.0 FEET)

[I 12] WOOD POST - G.E. ADAIR 1852
HEMLOCK 8 - N62°E 0.07 CHAINS IRONWOOD 9 - S62.5°W 0.15 CHAINS
CORNER IDENTIFIED AND REPLACED WITH IRON IN 1930 BY M.S. McNABB
FENCE COR POST - W. 30.0 FEET FENCE POST - E. 25.3 FEET

B. Description of corner evidence found and/or method applied in restoring or reestablishing corner:
[I 13] NO EVIDENCE OF ORIGINAL OR OF McNABB'S 1930 IRON FOUND, APPARENTLY DESTROYED DURING ROAD CONSTRUCTION. ID McNABB'S S1/4 COR AND E1/16 COR ALONG SOUTH LINE OF SECTION 34. ESTABLISHED NEW CORNER POSITION BY EXTENDING LINE EAST FROM S 1/4 CORNER THRU E1/16 CORNER AND SET SECTION CORNER AT PROPORTIONATE DISTANCE EAST OF E1/16 CORNER. ACCEPTED AS A CAREFUL AND FAITHFUL REESTABLISHMENT OF THE POSITION OF THE ORIGINAL CORNER.

[I 12] NO EVIDENCE OF ORIGINAL OR OF McNABB'S 1930 IRON STAKE FOUND, APPARENTLY DESTROYED DURING ROAD CONSTRUCTION. ESTABLISHED NEW CORNER POSITION AT MIDPOINT BETWEEN SECTION CORNERS NORTH AND SOUTH.

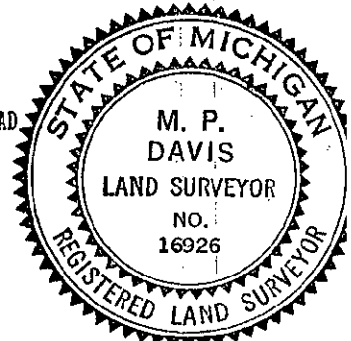

C. Description of monument for corner and accessories established to perpetuate locating the position of the corner:

[I 13] SET 5/8" X 18" REBAR W/A 3 1/4" ALUMINUM CAP STAMPED TO IDENTIFY THE CORNER POSITION.
CEDAR 4" POWER POLE 6" WELL PIPE STEEL SIGN POST
S56°E N57°E N53°W S62°W
102.63' 39.23' (TO FACE) 88.25' (TO CENTERLINE) 46.69' (TO FACE)

[I 12] SET 5/8" X 18" REBAR W/A 3 1/4" ALUMINUM CAP STAMPED TO IDENTIFY THE CORNER POSITION.
NE BUILDING CORNER SE BUILDING CORNER STEEL SIGN POST CHISEL X ON LARGE STONE
N28°W N67°W S57°E N57°E
124.50 63.69' 56.07' (TO FACE) 48.64'

NOTE: BEARINGS TO REFERENCE OBJECTS ARE MAGNETIC & DISTANCES ARE TO A NAIL IN THE CENTER OF THE OBJECT UNLESS OTHERWISE NOTED.

Signed by M.P. Davis Date 12/27/93
Surveyor's Michigan License No. 16926