

SURVEY & REMONUMENTATION

APR 24 1995

COMMISSION

LAND CORNER RECORDATION CERTIFICATE Filing Requirement of Act 74, Mich. P.A. 1970

Approved by Menominee County
Land Survey Remonumentation
Peer Group Under Act 345 Of
P.A. of 1990 On Dec. 9, 19994
William J. J...
Chairman

For corners in
MENOMINEE
(County)

Located In: Corner Code #

- | | | |
|------------------------------------|-----------------------------|---------------------------|
| 1. Public Land Survey | T <u>39</u> N R <u>25</u> W | 1-3 <u>6</u> / <u>1-3</u> |
| | T _____ R _____ | _____ |
| | T _____ R _____ | _____ |
| | T _____ R _____ | _____ |
| 2. Property Controlling in Section | S _____ T _____ R _____ | _____ |
| | S _____ T _____ R _____ | _____ |
| 3. Miscellaneous Property in Sec. | S _____ T _____ R _____ | _____ |
| | S _____ T _____ R _____ | _____ |

RECEIVED FOR RECORD
 94 DEC 27 AM 10:45
 PAGE # 197 BK 4
 BARBARA MORRISON
 REGISTER OF DEEDS
 MENOMINEE MI 49858

Register of Deeds Stamp & File Number

4. Lot No. _____, Recorded Plat _____
5. Private Claims 1-3 [NE COR SEC 10] J-3 [N1/4 COR SEC 11]

	A	B	C	D	E	F	G	H	I	J	K	L	M
2	6	5	4	3	2	1							
3													
4	7	8	9	10	11	12							
5													
6	18	17	16	15	14	13							
7													
8	19	20	21	22	23	24							
9													
10	30	29	28	27	26	25							
11													
12	31	32	33	34	35	36							
13													

I, M.P. DAVIS, in a field survey on OCTOBER, 1994, do hereby certify that under requirements of P.A. 74, Michigan P.A. of 1970, the corner points mentioned in lines 1 and 2 above were in conformance with regulations and rules therefore as required in the current manual of survey instructions of the United States Department of the Interior, Bureau of Land Management or by a decree of a Court of Law and/or that the corner points mentioned in lines 3, 4 and 5 above were in conformance with the rules of the Michigan Board of Land Surveyors or by a Decree of a Court of Law; established, re-established, monumented, re-monumented, recovered, found as expressed below:


NOTE: Not more than 4 corners, all in the same town and range, may be recorded on this certificate.

A. Description of original monument and accessories and/or subsequent restoration:

- I-3 [NE COR S.10] G. ADAIR D.S. - 1852 - WOOD POST (CEDAR 10"-S70°W-0.11 CHAINS) (HEMLOCK 18"-N81°E-0.11 CHAINS) NO RECORD EVIDENCE OF SUBSEQUENT CORNER RECOVERY OR MONUMENTATION.
- J-3 [N1/4 COR S.11] G. ADAIR D.S.- 1852 - WOOD POST (WHITE PINE 08"-N44-1/2°W-0.22 CHAINS) (CEDAR 12"-S54-1/2°E-0.10 CHAINS) M. S. MCNABE - 1941 - IN PLACE - NO WITNESSES NOTED OR DESCRIPTION OF MONUMENT GIVEN.

B. Description of corner evidence found and/or method applied in restoring or reestablishing corner:

- I-3 [NE COR S.10] NO CORNER EVIDENCE FOUND AS ALL EVIDENCE OF CORNER POSITION APPEARS TO HAVE BEEN DESTROYED DURING ROAD CONSTRUCTION. REESTABLISHED CORNER POSITION AT C/L INTERSECTION OF COUNTY ROADS N, S, E, & W. ACCEPTED THIS LOCATION AS BEING THE BEST AVAILABLE EVIDENCE AS TO THE POSITION OF THE ORIGINAL CORNER.
- J-3 [N1/4 COR S.11] NO CORNER EVIDENCE FOUND AS ALL EVIDENCE OF CORNER POSITION APPEARS TO HAVE BEEN DESTROYED DURING ROAD CONSTRUCTION. FOUND M. S. MCNABB'S (DELTA COUNTY SURVEYOR) 1936 E1/16 AND HIS 1941 NE CORNER OF SEC. 11. EXTENDED LINE WEST FROM SECTION CORNER THRU E1/16 CORNER AND RESET 1/4 CORNER ON THIS LINE AT A DISTANCE WEST OF THE E1/16 CORNER THAT IS EQUAL TO THE DISTANCE FROM THE SECTION CORNER TO THE E1/16 CORNER.

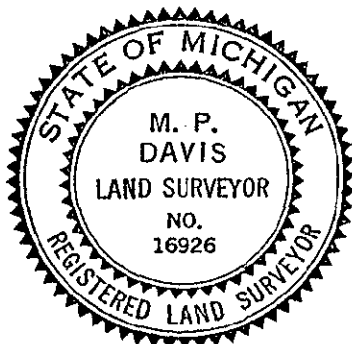

C. Description of monument for corner and accessories established to perpetuate localing the position of the corner:

- I-3 SET INSIDE A MON BOX A 5/8" X 18" REBAR W/A 3-1/4" ALUMN CAP STAMPED TO ID THE CORNER POSITION.
- | | | | |
|-----------|------------------|---------------------------|------------------|
| BALSAM 5" | POWER POLE | SURVEY MONUMENT SIGN POST | POWER POLE |
| N37°W | S58°W | N49°E | S57°E |
| 74.64' | 48.47' (TO FACE) | 42.16' (TO FACE) | 46.58' (TO FACE) |
- J-3 SET INSIDE A MON BOX A 5/8" X 18" REBAR W/A 3-1/4" ALUMN CAP STAMPED TO ID THE CORNER POSITION.
- | | | |
|----------|-----------|---------------------------|
| CEDAR 4" | CEDAR 12" | SURVEY MONUMENT SIGN POST |
| S10°W | S54°E | NORTH |
| 27.91' | 32.69' | 17.50' (TO FACE) |

NOTE: BEARINGS TO REFERENCE OBJECTS ARE MAGNETIC & DISTANCES ARE TO A NAIL IN THE CENTER OF THE OBJECT, UNLESS OTHERWISE NOTED.

Signed by M.P. Davis Date 12/9/94
 Surveyor's Michigan License No. 16926