

# SURVEY & REMONUMENTATION

JUN 23 1994

## LAND CORNER RECORDATION CERTIFICATE Filing Requirement of Act 74, Mich. P.A. 1970

Approved by Menominee County  
Land Survey Remonumentation  
Peer Group Under Act 345 Of  
P.A. Of 1990 On 5/18 1994  
Mike Davis  
Chairman

For corners in COMMISSION  
MENOMINEE

	Located In:	Corner Code #
1. Public Land Survey	T <u>39N</u> R <u>26W</u>	<u>E-11</u>
	T _____ R _____	_____
	T _____ R _____	_____
	T _____ R _____	_____
2. Property Controlling in Section	S _____ T _____ R _____	_____
	S _____ T _____ R _____	_____
3. Miscellaneous Property in Sec.	S _____ T _____ R _____	_____
	S _____ T _____ R _____	_____

RECEIVED FOR RECORD


94 MAY 20 PM 3:33

PAGE # 77 BK. 4

BARBARA MORRIS  
REGISTER OF DEEDS  
MENOMINEE, MI 49858

Register of Deeds Stamp & File Number

4. Lot No. \_\_\_\_\_, Recorded Plat \_\_\_\_\_
5. Private Claims \_\_\_\_\_

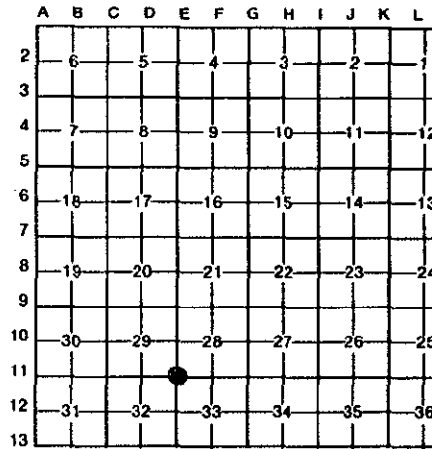

I, William Lenca, in a field survey on Apr 19, 1994, do hereby certify that under requirements of P.A. 74, Michigan P.A. of 1970, the corner points mentioned in lines 1 and 2 above were in conformance with regulations and rules therefore as required in the current manual of survey instructions of the United States Department of the Interior, Bureau of Land Management or by a decree of a Court of Law and/or that the corner points mentioned in lines 3, 4 and 5 above were in conformance with the rules of the Michigan Board of Land Surveyors or by a Decree of a Court of Law, established, re-established, monumented, re-monumented, recovered, found as expressed below:

**NOTE: Not more than 4 corners, all in the same town and range, may be recorded on this certificate.**

**A. Description of original monument and accessories and/or subsequent restoration:**

1852 - Original Survey by Harvey Mellen - B.T.'s - Cedar, 14", N39°E, 38 lks ; Hemlock, 20", S55°W, 08 lks. Found remnants of Hemlock stump in proper location. Found no evidence of Cedar B.T.

**B. Description of corner evidence found and/or method applied in restoring or reestablishing corner:**

We found a 2-1/2" dia. Iron Pipe and an old squared wood post of unknown origin by retracement of the South Line of Section 28, T39N-R26W. We found remnants of a Hemlock stump in position matching the above Hemlock B.T. The GLO record distances to the S1/4 Corner and W1/4 Corner are 2651.2 feet and 2600.4 feet respectively. We measured these distances to be 2655.19 feet and 2603.65 feet respectively. Based on the above information, we accepted the existing iron pipe as a careful and faithful perpetuation of the position of the original corner.



**C. Description of monument for corner and accessories established to perpetuate locating the position of the corner:**  
Set 3/4" Aluminum Rod 5' long/3-1/4" dia. Alum. cap stamcd for corner in position of existing 2-1/2" dia. Iron Pipe:

8" dia. Balsam	Scr. NBT	N09°W	11.85 feet
5" dia. Maple	Scr. NBT	S60°E	10.58 feet
7" dia. White Spruce	Scr. NBT	S06°W	16.38 feet
5" dia. Maple	Scr. NBT	S87°W	38.61 feet
Carsonite Marker		East	2.3 feet

NOTE: All bearings are magnetic bearings. All distances are measured with steel tape. Distances to trees are to nail in side of tree.

Signed by William Lenca Date May 19, 1994  
Surveyor's Michigan License No. 26461