Approved by Menominee County
Land Survey Remonumentation
Peer Group Under Act 345 Of
P.A. Of 1990 On 9/25 1996
Chairman

LAND CORNER RECORDATION CERTIFICATE
Filing Requirement of Act 74, Mich. P.A. 1970

For corners in

MENOMINEE
(County)

	Located In:	Corner Code #
1. Public Land Survey	T40N R 25W	G12
	T___ R___	
	T___ R___	
	T___ R___	
2. Property Controlling	S___ T___ R___	
in Section	S___ T___ R___	
3. Miscellaneous	S___ T___ R___	
Property in Sec.	S___ T___ R___	

RECEIVED FOR RECORD
96 OCT -7 PM 3:23
BARBARA MORRISON
REGISTER OF DEEDS
Liber 336 Bk. 4

Register of Deeds Stamp & File Number

4. Lot No. _____, Recorded Plat _____
5. Private Claims _____

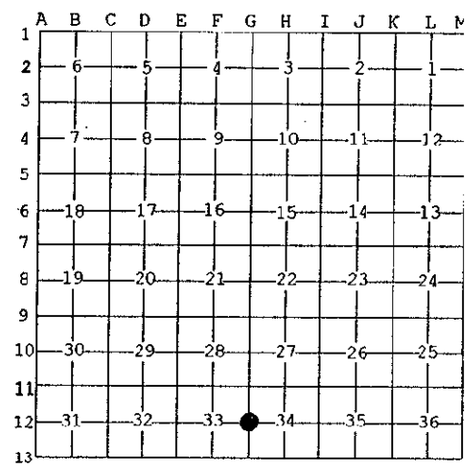

I, William Lenca, in a field survey on Aug. 12, 19 96 do hereby state that under requirements of P.A. 74, Michigan P.A. of 1970, the corner points mentioned in lines 1 and 2 above were in conformance with regulations and rules therefore as required in the current manual of survey instructions of the United States Department of the Interior, Bureau of Land Management or by a decree of a Court of Law and /or that the corner points mentioned in lines 3, 4 and 5 above were in conformance with the rules of the Michigan Board of Land Surveyors or by a Decree of a Court of Law; established, re-established, monumented, recovered, found as expressed below:

NOTE: Not more than 2 corners, all in the same town and range, may be recorded on this certificate.

A. Description of original monument and accessories and/or subsequent restoration:

1852: Original Survey by Harvey Mellen - B.T.'s - Cedar, 12" - N88°E - 14 lks; Cedar, 12" - N40°W - 15 links. All original evidence for this corner has been destroyed by county road improvements.

B. Description of corner evidence found and/or method applied in restoring or reestablishing corner:

This corner was set by single proportion between the Northwest Corner and the Southwest Corner of Section 34, T40N - R25W. The corner position falls in the centerline of a North - South County Road and fits well with a GLO call to a swamp 24 feet South, and is accepted as a careful and faithful reestablishment of the position of the original corner.

STATE OF MICHIGAN
WILLIAM LENCA
LAND SURVEYOR
No. 26461
REGISTERED LAND SURVEYOR

C. Description of monument for corner and accessories established to perpetuate locating the position of the corner:
Set 5/8" x 24" Iron Rod/3-1/4" dia. Alum. cap stamped for corner location:

5" dia. Cedar	N36°E	29.98 feet	Scr. NBT
8" dia. Tamarack	S39°E	47.67 feet	Scr. NBT
16" dia. White Spruce	N36°W	45.08 feet	Scr. NBT
5/8" x 24" Iron Rod/2" dia. Alum. cap marked "WITNESS MARKER"	N90°W	19.87 feet	
Metal Survey Sign Post	N90°W	20.4 feet	

NOTE: All bearings are magnetic bearings. All distances are measured with steel tape. Distances to trees are to nail in side of tree.

Signed by William Lenca Date Aug. 30, 1996
Surveyor's Michigan License No. 26461

FORM APPROVED BY MICHIGAN STATE BOARD OF PROFESSIONAL SURVEYORS, JAN. 28, 1971
REVISED MAY 14,1975
REVISED JAN., 1983
REVISED OCT., 1995