Approved by Menominee County
Land Survey Remonumentation
Peer Group Under Act 345 Of
P.A. Of 1990 On 9/25 199 96
Chairman

LAND CORNER RECORDATION CERTIFICATE
Filing Requirement of Act 74, Mich. P.A. 1970

For corners in
MENOMINEE
(County)

	Located In:	Corner Code #
1. Public Land Survey	T40N R 25W	H11
	T___ R___	
	T___ R___	
	T___ R___	
2. Property Controlling in Section	S___ T___ R___	
	S___ T___ R___	
3. Miscellaneous Property in Sec.	S___ T___ R___	
	S___ T___ R___	

RECEIVED FOR RECORD
96 OCT -7 PM 3:23
338 BK.4
BARBARA MORRISON
REGISTER OF DEEDS
MENOMINEE COUNTY

Register of Deeds Stamp & File Number

4. Lot No. _____, Recorded Plat _____
5. Private Claims _____

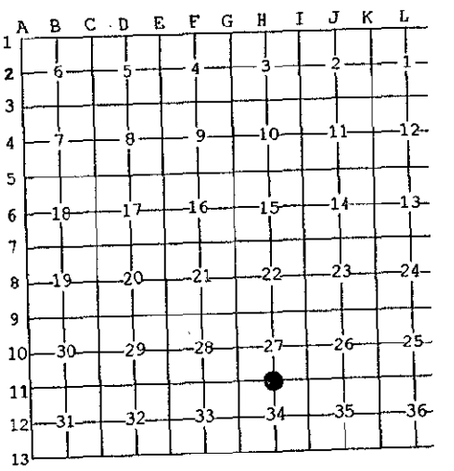

I, William Lenca, in a field survey on Aug. 12, 19 96 do hereby state that under requirements of P.A. 74, Michigan P.A. of 1970, the corner points mentioned in lines 1 and 2 above were in conformance with regulations and rules therefore as required in the current manual of survey instructions of the United States Department of the Interior, Bureau of Land Management or by a decree of a Court of Law and /or that the corner points mentioned in lines 3, 4 and 5 above were in conformance with the rules of the Michigan Board of Land Surveyors or by a Decree of a Court of Law; established, re-established, monumented, recovered, found as expressed below:

NOTE: Not more than 2 corners, all in the same town and range, may be recorded on this certificate.

A. Description of original monument and accessories and/or subsequent restoration:

1852: Original Survey by Harvey Mellen - B.T.'s - Y. Birch, 20" - N69°E - 17 lks; Sugar, 16" - S78°W - 11 links. No original evidence for this corner was recovered.

B. Description of corner evidence found and/or method applied in restoring or reestablishing corner:

This corner was set by single proportion between the Northwest Corner and the Northeast Corner of Section 34, T40N - R25W, and is accepted as a careful and faithful reestablishment of the position of the original corner.

C. Description of monument for corner and accessories established to perpetuate locating the position of the corner:
Set 2" dia. Aluminum Pipe/3-1/4" dia. Alum cap stamped for corner location:

5" dia. Ironwood	N75°E	20.76 feet	Scr. NBT
12" dia. White Spruce	S43°E	25.61 feet	Scr. NBT
8" dia. Ironwood	S50°W	17.73 feet	Scr. NBT
5" dia. Ironwood	N46°W	26.04 feet	Scr. NBT
Metal Survey Sign Post	S26°E	1.0 feet	

STATE OF MICHIGAN
WILLIAM LENCA
LAND SURVEYOR
No. 26461
REGISTERED LAND SURVEYOR

NOTE: All bearings are magnetic bearings. All distances are measured with steel tape. Distances to trees are to nail in side of tree.

Signed by William Lenca
Surveyor's Michigan License No. 26461

Date Aug. 30, 1996

FORM APPROVED BY MICHIGAN STATE BOARD OF PROFESSIONAL SURVEYORS, JAN. 28,
REVISED MAY 14
REVISED JAN.,
REVISED OCT.,

330