

**LAND CORNER RECORDATION CERTIFICATE**  
**Filing Requirement of Act 74, Mich. P.A. 1970 as Amended**

For corners in

<u>Menominee</u> (County)	Located In:	Corner Code #
1. Public Land Survey	T 40N R 26W	K12
	T 40N R 26W	M12
	T _____ R _____	_____
2. Property Controlling in Section	S _____ T _____ R _____	_____
	S _____ T _____ R _____	_____
	S _____ T _____ R _____	_____
3. Miscellaneous Property in Sec.	S _____ T _____ R _____	_____
	S _____ T _____ R _____	_____
4. Lot No. _____, Recorded Plat _____		
5. Private Claims _____		

Register of Deeds Stamp & File Number

	A	B	C	D	E	F	G	H	I	J	K	L	M
1													
2	6		5		4		3		2		1		
3													
4	7		8		9		10		11		12		
5													
6	18		17		16		15		14		13		
7													
8	19		20		21		22		23		24		
9													
10	30		29		28		27		26		25		
11													
12	31		32		33		34		35		36		
13													

I, Jeremy J. Pipp, in a field survey on 7/01/2013AD do hereby state that under requirements of P.A. 74, Michigan P.A. of 1970, the corner points mentioned in lines 1 and 2 above were in conformance with regulations and rules therefore as required in the current manual of survey instructions of the United States Department of the Interior, Bureau of Land Management or by a decree of a Court of Law and /or that the corner points mentioned in lines 3, 4 and 5 above were in conformance with the rules of the Michigan Board of Land Surveyors or by a Decree of a Court of Law; established, re-established, monumented, recovered, found as expressed below:

NOTE: Not more than 2 corners, all in the same town and range, may be recorded on this certificate.

A. Description of original monument and accessories and/or subsequent restoration:

(K12) Quarter corner common to Sections 35 and 36. 1852: Harvey Mellen, DS. Set Qr. Section post witnessed by Sugar 14 S03E 19 links (12.54'), Sugar 12 N84E 35 links (23.10'). 1971: Michigan DNR (Frank Bray PS#13575) Set 1" pipe with 4" Aluminum cap witnessed by 10" W. Birch N39E 89.1', 9" B. Cherry S72E 62.7'.

(M12) Quarter corner common to Sections 31 and 36. 1848: H. Brevort Jr., DS. Set quarter section post witnessed by Birch 10 N77W 05 links (3.30'), W. Pine 8 S75W 09 links (5.94'). 1971: Michigan DNR (Frank Bray PS#13575) Set 1" pipe with 4" Aluminum cap witnessed by 7" Cedar N58W 16.4', 6" Balsam N73E 5.6'.

B. Description of corner evidence found and/or method applied in restoring or reestablishing corner:

(K12) Accepted found MDNR Monument and Two existing NBT Witnesses (W. Birch dead & down, B. Cherry living). Position is accepted as a careful and faithful REESTABLISHMENT of the position of the original corner.

(M12) Accepted found MDNR Monument and remains of two existing NBT Witnesses (dead & down). Position is accepted as a careful and faithful REESTABLISHMENT of the position of the original corner.

C. Description of monument for corner and accessories established to perpetuate locating the position of the corner:


(K12) DNR monument  
 4" Cherry N43E 23.29' (1/4S,NBT)  
 EX 15" Cherry S70E 63.18' (1/4S,NBT)  
 5" Poplar S19W 34.47' (1/4S,NBT)  
 13" Cherry N75W 35.41' (1/4S,NBT)

All trees are blazed, scribed, painted, and signed. Measurements are to nail in side of tree, bearings are magnetic. A metal sign post was set North 1.5 feet.

(M12) DNR monument  
 10" Cedar N65E 29.90' (1/4S,NBT)  
 6" Balsam S13E 3.08' (1/4S,NBT)  
 22" Hemlock S09W 32.85' (1/4S,NBT)  
 14" Cedar N40W 13.89' (1/4S,NBT)

All trees are blazed, scribed, painted, and signed. Measurements are to nail in side of tree, bearings are magnetic. A metal sign post was set North 1.5 feet.

Signed by Jeremy J. Pipp  
 Surveyor's Michigan License No. 50447

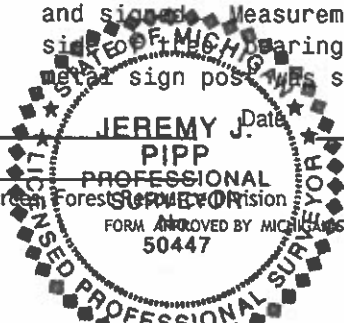

For the Michigan Department of Natural Resources Forest Resources Division

Date August 08, 2013

20242  
 20243