

25

Approved by Menominee County
Lead Survey Remuneration
Peer Group Under Act 345 Of

P.A. Of 1990 On Dec. 20, 1995

William J. ...
Chairman

LAND CORNER RECORDATION CERTIFICATE
Filing Requirement of Act 74, Mich. P.A. 1970

For corners in

Menominee

(County)

Located in:

Corner Code ~~##~~

- 1. Public Land Survey
 - T 41N R 26W M6 (A6 T41N, R25W)
 - T 41N R 26W M7 (A7 T41N, R25W)
 - T _____ R _____
 - T _____ R _____
- 2. Property Controlling in Section
 - S _____ T _____ R _____
 - S _____ T _____ R _____
- 3. Miscellaneous Property in Sec.
 - S _____ T _____ R _____
 - S _____ T _____ R _____

Register of Deeds Stamp & File Number

- 4. Lot No. _____, Recorded Plat _____
- 5. Private Claims _____

M7 March 13, 1995

I, Paul R. Bressette, in a field survey on M6 May 23, 1995, 19 _____, do hereby certify that under requirements of P.A. 74, Michigan P.A. of 1970, the corner points mentioned in lines 1 and 2 above were in conformance with regulations and rules therefore as required in the current manual of survey instructions of the United States Department of the Interior, Bureau of Land Management or by a decree of a Court of Law and/or that the corner points mentioned in lines 3, 4 and 5 above were in conformance with the rules of the Michigan Board of Land Surveyors or by a Decree of a Court of Law; established, re-established, monumented, re-monumented, recovered, found as expressed below:

| | | | | | | | | | | | | | |
|----|----|---|----|---|----|---|----|---|----|---|----|---|---|
| | A | B | C | D | E | F | G | H | I | J | K | L | M |
| 2 | 6 | | 5 | | 4 | | 3 | | 2 | | 1 | | |
| 3 | | | | | | | | | | | | | |
| 4 | 7 | | 8 | | 9 | | 10 | | 11 | | 12 | | |
| 5 | | | | | | | | | | | | | |
| 6 | 18 | | 17 | | 16 | | 15 | | 14 | | 13 | | |
| 7 | | | | | | | | | | | | | |
| 8 | 19 | | 20 | | 21 | | 22 | | 23 | | 24 | | |
| 9 | | | | | | | | | | | | | |
| 10 | 30 | | 29 | | 28 | | 27 | | 26 | | 25 | | |
| 11 | | | | | | | | | | | | | |
| 12 | 31 | | 32 | | 33 | | 34 | | 35 | | 36 | | |
| 13 | | | | | | | | | | | | | |

NOTE: Not more than 4 corners, all in the same town and range, may be recorded on this certificate.

A. Description of original monument and accessories and/or subsequent restoration:

(M6) Quarter corner common to Sections 13 and 18. 1846: Austin Burt, DS. Set sugar post witnessed by: Hemlock 8 S29E 21 lks.; Hemlock 14 N28W 28 lks. 1963: Billy Buckler, RLS. Set 1" iron pipe with 4" brass cap mid-point and on-line between the Northeast and Southeast corners of Section 13 witnessed by: 8" H. Maple N62W 16 lks.; 7" H. Maple N06E 26 1/2 lks. Corner is recorded in Vol.2, p.357 of Menominee County Records.

(M7) Section corner common to Sections 13, 24, 18 and 19. 1846: Austin Burt, DS. Set tamarack post witnessed by: Birch 10 S25W 13 links; fir 6 N68E 11 links. 1852: E.C. Martin, DS. Closed on corner during subdivision of T41N, R25W and T41N, R26W and marked two additional witnesses: Cedar 8 S25E 20 links (June); Cedar 8 N40W 21 links (July). 1951: Michigan Dept. of Conservation. Set 1" iron pipe w/ brass cap from two original BT's in excellent condition witnessed by: 12" Cedar N30E 11 links; 12" Cedar S45E 8 links; 12" Cedar S71W 4 links. Corner is recorded in Vol.3, p.832 of Menominee County Records.

B. Description of corner evidence found and/or method applied in restoring or reestablishing corner:


(M6) Found monument and witnesses as described. NE NBT is dead but standing N12E 17.7' from monument with blazes open and scribing plain. NW NBT is alive and standing in excellent condition with both faces completely closed. Measurement made to face of tree. Monument stands about 2 feet above grade due to large rock below. Monument was firmed up and re-witnessed, and is accepted as a careful and faithful REESTABLISHMENT of the position of the original corner.

(M7) Found monument as described and two witnesses SE and SW but not of record. Witnesses were blazed and scribed. Measurements to corners north show corner has not been moved from 1951 position. Monument was re-witnessed as found, and is accepted as a careful and faithful PERPETUATION of the position of the original corner.

C. Description of monument for corner and accessories established to perpetuate locating the position of the corner:

(M6) 1" iron pipe w/ 4" brass cap
10" Cedar N37E 22.25' (1/4S, NBT)
08" Maple S38E 39.0' (1/4S, NBT)
11" Sugar S56W 40.85' (1/4S, NBT)
13" Sugar N54W 10.0' (old NBT)
All NBT's are blazed, scribed, painted and tagged. A metal post with sign was placed next to monument. Distances are measured to notch in butt blaze, except old NBT which is measured to face, bearings are magnetic.

(M7) 1" iron pipe w/ brass cap
7" Cedar N36E 47.1' (1/4S, NBT)
8" Cedar S29E 5.6' (1/4S, NBT)
10" Cedar S42W 3.65' (1/4S, NBT)
7" Cedar N39W 33.8' (1/4S, NBT)
All NBT's are blazed, scribed, painted and tagged. A metal post with sign was placed next to monument. Distances are measured to notch in butt blaze, bearings are magnetic.

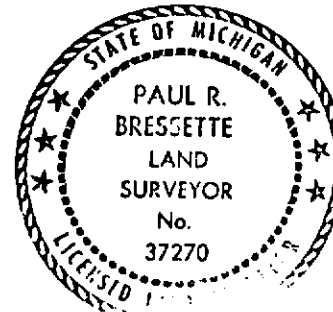

Signed by Paul R. Bressette Date 1-3-95

Surveyor's Michigan License No. 37270