

MICHIGAN  
DEPARTMENT OF CONSERVATION  
FORESTRY DIVISION

LAND CORNER RECORD

T. 21 N.R. 5 W


Missaukee COUNTY

DESCRIPTION OF CORNER Section corner common to sections 11, 12, 13, 14

CORNER MONUMENT Set Cons. Dept. Mon.

DATE MONUMENT PLACED AND WITNESSED 8/29/67

WITNESSES TO CORNER.....

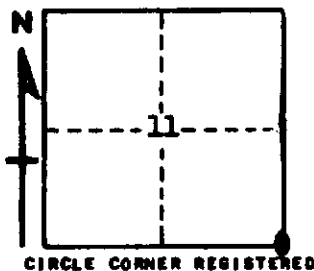

5" Balsam S 62 W 16.0°

10" R. Pine N 10 W 49.9°

AND

DESCRIPTION IN DETAIL AS TO HOW CORNER WAS LOCATED AND IDENTIFIED OR RESTORED.

This corner was found during a retracement in this township. Found 1½" pipe as previously restored by Marcus Schaaf during 1938 survey. One possible USBT stump in place N.W. Fits for line and distance over good corners south. Unable to identify McBain's earlier corner which may have been destroyed in road construction.

SURVEYOR'S SEAL

SIGNED *Kenneth J. Ostling* DATE 9/20/67  
REGISTERED LAND SURVEYOR 410068