

MICHIGAN  
DEPARTMENT OF CONSERVATION  
FORESTRY DIVISION

# LAND CORNER RECORD

T. 21 N. R. 5 W


Missaukee COUNTY

DESCRIPTION OF CORNER Section corner common to Sections 13-14-23-24

CORNER MONUMENT Set Cons. Dept. monument

DATE MONUMENT PLACED AND WITNESSED 8/1/67

WITNESSES TO CORNER.....

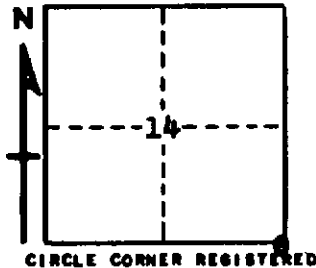

12" B. Oak N 53 W 51.4'

Trin 7" B. Oak S 39 E 58.8'

AND

DESCRIPTION IN DETAIL AS TO HOW CORNER WAS LOCATED AND IDENTIFIED OR RESTORED.

This corner was found during a survey in this township. Found pipe in concrete monument below surface of road at point prescribed by witnesses of record from early survey by county surveyor. Checks good all directions. Falls in center of N-S county road, in line with old fence west.

SURVEYOR'S SEAL

SIGNED *Kenneth J. Pelling* DATE 8/28/67  
REGISTERED LAND SURVEYOR

#10068