LAND CORNER RECORDATION CERTIFICATE

Filing Requirement of Act 74, Mich. P.A. 1970

filed 7-24-87 MPW

For corners in
MISSAUKEE
(County)

	Located In:	Corner Code ##
1. Public Land Survey	T 21N R 5W	N-4
	T ___ R ___	N-5
	T ___ R ___	
	T ___ R ___	
2. Property Controlling	S 12 T ___ R ___	14
in Section	S ___ T ___ R ___	
3. Miscellaneous	S ___ T ___ R ___	
Property in Sec.	S ___ T ___ R ___	

Register of Deeds Stamp & File Number

4. Lot No. _____ , Recorded Plat _____
5. Private Claims _____

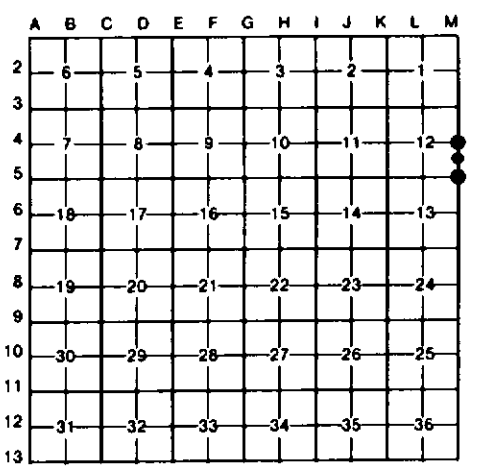

I, CARL F. ROSER, in a field survey on OCTOBER 20, 19 87, do hereby certify that under requirements of P.A. 74, Michigan P.A. of 1970, the corner points mentioned in lines 1 and 2 above were in conformance with regulations and rules therefore as required in the current manual of survey instructions of the United States Department of the Interior, Bureau of Land Management or by a decree of a Court of Law and/or that the corner points mentioned in lines 3, 4 and 5 above were in conformance with the rules of the Michigan Board of Land Surveyors or by a Decree of a Court of Law; established, re-established, monumented, re-monumented, recovered, found as expressed below:

NOTE: Not more than 4 corners, all in the same town and range, may be recorded on this certificate.

A. Description of original monument and accessories and/or subsequent restoration:

N-4	N-5	14

B. Description of corner evidence found and/or method applied in restoring or reestablishing corner:

N-4	N-5	14
RESTORED E 1/4 COR S-12 FROM TWO U.S.B.T. Y.PINE STUMPS. SCHAAF HERE ALSO IN 1938. COR FALLS IN APPROX CTR OF E-W WINDING TRAIL ROAD.	FD SCHAAF PIPE AND STUMP REMAINS OF TWO OF SCHAAF'S N.B.T'S. SCHAAFS NOTES (1938) INDICATE HE HAD ALL THREE U.S.(G.L.O.) Y.PINE B.T'S OF WHICH TWO ARE STILL EVIDENT. FD 3/4" X 94" ± SOLID ROD ALONGSIDE PIPE, PULLED ROD AND DROVE INSIDE 2" PIPE & LEFT ABOUT 1' ABOVE GROUND. COR FITS U.S. STREAM TIE TO WEST, 132'.	DROVE 5/8" X 34" REROD FOR SE COR. NE 1/4-SE 1/4 OF S-12, PER STANDARD B.L.M. INSTRUCTIONS.

C. Description of monument for corner and accessories established to perpetuate locating the position of the corner:

N-4

DROVE 5/8" X 34" REROD W/RLS CAP & BURIED 6" X 6" X 5" CONC BLK W/SHORT 1 1/2" PIPE ALONGSIDE.

17" W OAK	N45°W	16.0'
18" R PINE	N25°E	29.3'
18" OAK	S45°E	19.5'
14" OAK	S60°W	38.9'
SET CED POST W/LOC TAG	DUE N	16.5'

N-5

FD 2" PIPE W/ 3/4" SOLID ROD DRIVEN INSIDE & SET CED POST W/LOC TAG.

11" MAPLE	N25°E	20.0'
6" MAPLE	S64°E	11.3'
21" R PINE	S66°W	50.0'
7" W PINE	N42°W	22.8'

14

DROVE 5/8" X 34" REROD W/RLS CAP & SET CED POST W/LOC TAG.

16" MAPLE	S47°W	112.6'
2" W PINE	N48°W	43.9'
6" CEDAR	N42°E	69.7'
20" W PINE	N86°E	86.4'

SINGLE STRAND SMOOTH WIRE N-G IN TREES IS 65'± WEST.

STATE OF MICHIGAN
CARL F. ROSER
LAND SURVEYOR
No. 12028
REGISTERED LAND SURVEYOR

Signed by Carl F. Roser 10-25-88 Date _____

Surveyor's Michigan License No. 12028

FORM APPROVED BY MICHIGAN STATE BOARD OF LAND SURVEYORS, JAN. 28, 1971
REVISED MAY 14, 1975
REVISED JAN., 1983