LAND CORNER RECORDATION CERTIFICATE

Filing Requirement of Act 74, Mich. P.A. 1970

filed 7-24-89 JPW

For corners in MISSAUKEE (County)

	Located In:	Corner Code ##
1. Public Land Survey	T 21N R 5W	K-4
	T ___ R ___	
	T ___ R ___	
	T ___ R ___	
2. Property Controlling	S ___ T ___ R ___	
in Section	S ___ T ___ R ___	
3. Miscellaneous	S 11 T ___ R ___	#USMC 509.6
Property in Sec.	S ___ T ___ R ___	6 OF K-4

Register of Deeds Stamp & File Number

4. Lot No. _____ , Recorded Plat _____
5. Private Claims _____

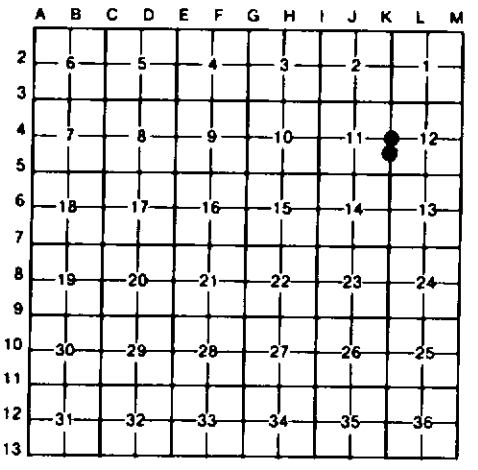

I, CARL F. ROSER, in a field survey on OCTOBER 28, 19 87, do hereby certify that under requirements of P.A. 74, Michigan P.A. of 1970, the corner points mentioned in lines 1 and 2 above were in conformance with regulations and rules therefore as required in the current manual of survey instructions of the United States Department of the Interior, Bureau of Land Management or by a decree of a Court of Law and/or that the corner points mentioned in lines 3, 4 and 5 above were in conformance with the rules of the Michigan Board of Land Surveyors or by a Decree of a Court of Law; established, re-established, monumented, re-monumented, recovered, found as expressed below:

NOTE: Not more than 4 corners, all in the same town and range, may be recorded on this certificate.

A. Description of original monument and accessories and/or subsequent restoration:

K-4

K-4 CONT.

#

B. Description of corner evidence found and/or method applied in restoring or reestablishing corner:

K-4

RESTORED E 1/4 COR OF S-11 ON LINE ACROSS RECOV'D USMC TO SO & RECOVERED SE COR S-11 AND AT PRORATED DISTANCE, TO M.SCHAAF DISTANCE, N OF SAID U.S.M.C., SCHAAF NOTES (1938) INDICATE THE RV HAS CHANGED SINCE G.L.O RESURVEY IN 1852 (THIS IS TRUE) AND THAT THE COR FALLS IN PRESENT BEND IN RV BY 22 LINKS (THIS IS ALSO TRUE). 1/4 COR AS RESTORED ABOVE FITS

K-4 CONT.

SCHAAF DEFLECTION AT 1/4 COR BETW NE & SE S-11 AND IS ALSO SUPPORTED BY BEING ALMOST ON LINE BETW FD W 1/4 & FD CTR OF S-11, S-11 HAVING BEEN SUBDIVIDED BY CO SUR J.D.MCBAIN IN 1907.

#

RESTORED U.S.M.C. ON N. SIDE OF MUSKEGON RV.,SAID U.S.M.C. BEING S00°33'27"E, 509.62' FROM E 1/4 COR S-11. 1938 SCHAAF NOTES SAY "INTERSECT MEANDER COR N SIDE OF RV., BOTH U.S.B.T. STUMPS PLAIN". WE RECOV'D 1 U.S.B.T STUMP (NAP NW) & FIT SCHAAF ALIGNMENT & DISTANCE ON E LINE S-11. ALSO SEE LAND COR RECORD FOR E 1/4 COR S-11.

C. Description of monument for corner and accessories established to perpetuate locating the position of the corner:

K-4

CALC 1/4 COR FALLS IN RV BEND. COULD NOT SET IR. REF MARK 1: DROVE 5/8" X 34" REROD W/RLS CAP & SET CED POST W/LOC TAG.

5" MAPLE	S48°W	12.64'
8" ASH	N20°E	3.39'

CALC 1/4 COR IN RVR S00°11'02"E 54.80'

K-4 CONT.

REF MARK 2: DROVE 5/8" X 34" REROD W/RLS CAP & SET CED POST W/LOC TAG.

8" MAPLE	S48°E	14.0'
3" OAK	N86°E	19.94'

CALC 1/4 COR IN RVR N00°33'27"W 84.27'

#

DROVE 5/8" X 34" REORD W/RLS CAP & SET CED POST W/LOC TAG.

24" W PINE	N48°W	52.6'
28" OAK	N22°E	18.2'
10" MAPLE	S42°W	32.9'
N EDGE RVR	SOUTH	52'±

(CONT)

Signed by Carl F. Roser 10-25-88 Date _____

Surveyor's Michigan License No. 12028

STATE OF MICHIGAN
CARL F. ROSER
LAND SURVEYOR
No. 12028
REGISTERED LAND SURVEYOR

FORM APPROVED BY MICHIGAN STATE BOARD OF LAND SURVEYORS, JAN. 28, 1971
REVISED MAY 14, 1975
REVISED JAN., 1983