LAND CORNER RECORDATION CERTIFICATE

Filing Requirement of Act 74, Mich. P.A. 1970

filed 7-24-89 RW

For corners in
MISSAUKEE
(County)

	Located In:	Corner Code ##
1. Public Land Survey	T 21N R 5W	G-5
	T ___ R ___	E-5
	T ___ R ___	G-4
	T ___ R ___	F-5
2. Property Controlling	S ___ T ___ R ___	
in Section	S ___ T ___ R ___	
3. Miscellaneous	S ___ T ___ R ___	
Property in Sec.	S ___ T ___ R ___	

Register of Deeds Stamp & File Number

4. Lot No. _____ , Recorded Plat _____
5. Private Claims _____

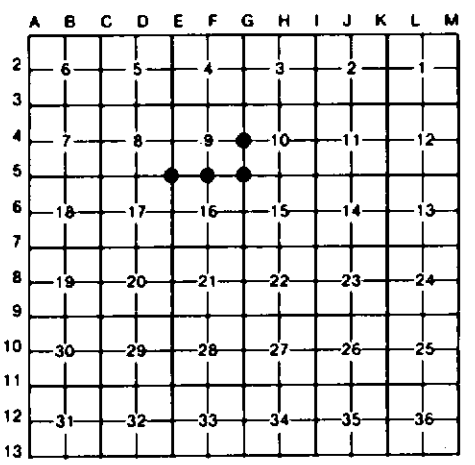

F-5

I, CARL F. ROSER, in a field survey on APRIL 22, 19 87, do hereby certify that under requirements of P.A. 74, Michigan P.A. of 1970, the corner points mentioned in lines 1 and 2 above were in conformance with regulations and rules therefore as required in the current manual of survey instructions of the United States Department of the Interior, Bureau of Land Management or by a decree of a Court of Law and/or that the corner points mentioned in lines 3, 4 and 5 above were in conformance with the rules of the Michigan Board of Land Surveyors or by a Decree of a Court of Law; established, re-established, monumented, re-monumented, recovered, found as expressed below:

NOTE: Not more than 4 corners, all in the same town and range, may be recorded on this certificate.

A. Description of original monument and accessories and/or subsequent restoration:

G-5

E-5

G-4

B. Description of corner evidence found and/or method applied in restoring or reestablishing corner:

G-5
FD 1 1/2" PIPE BY M.SCHAAF FOR SE COR G-9 (FITS 2 SCHAAF WITS M.PINE STP N5°W 59.4' & N PINE STP N19°E 41.4';FD REMAINS OF BOTH STPS). FD 5/8" PIPE BY J D. MCBAIN S63°50'23"E 37.36'. COR IS AT N EDGE OF E-W SAND RD & AT E EDGE TRAIL TO NORTH.

E-5
FD 1" PIPE (& 1/4" X 1" IRON BAR ALONGSIDE) FOR SW COR G-9; CORNER FALLS IN INTER. OF GRAVEL RDS N-E-W & 5' E OF CTR TRAIL RD TO SO.

G-4
FD 1 1/4" PIPE; ACCEPTED FOR E 1/4 COR OF G-9.

F-5
FD 1 1/4" PIPE FOR S 1/4 COR S-9 AS ESTAB'D BY M.SCHAAF. FD PIPE BY MCBAIN S84°54'42"E 20.52'. FN COR (FN-W.WIRE W/B.WIRE W & N & SINGLE WIRE E) IS 33 1/2'E & 30'N. COR IS AT N EDGE E-W TRAIL.

C. Description of monument for corner and accessories established to perpetuate locating the position of the corner:

G-5
FD 1 1/2" X 54" PIPE. REPL'D W/ 5/8" X 34" REROD W/RLS CAP.

6" MAPLE	N34°W	35.9'
16" TW OAK	N56°E	57.1'
8" R OAK	S41°E	56.9'
6" W OAK	S18°W	18.8'
SET CED POST W/LOC TAG.	NORTH	16 1/2'±

E-5
FD 1" X 18" PIPE WITH 1/4" X 1" IRON BAR ALONGSIDE. DROVE 5/8" X 34" REROD W/RLS CAP INSIDE 1" PIPE.

P POLE	N38°W	73.90'
7" W OAK TW	S42°E	38.75'
28" W OAK	S60°W	61.13'
6" W PINE	N46°E	59.65'

G-4
FD 1 1/4" PIPE; ADDED CED POST W/LOC TAG

4" OAK	N20°E	5.6'
6" OAK	S25°E	8.8'
9" OAK	S80°W	12.8'
N-S WOVEN WIRE FN	EAST	38'±
N-S WOODS TRAIL	EAST	31'±

F-5
FD 1 1/4" PIPE (BURIED 6")

3" MAPLE	N61°W	20.6'
6" MAPLE	N20°E	15.1'
6" MAPLE	S30°E	31.0'
8" R OAK	S61°W	39.8'
SET CED POST W/LOC TAG	NORTH	16.5'
FD 1/2" PIPE W/COUPLING N84°54'42"E 20.52'		

Signed by Carl F. Roser 10-25-88 Date _____

Surveyor's Michigan License No. 12028

STATE OF MICHIGAN
CARL F. ROSER
SURVEYOR
No. 12028
REGISTERED LAND SURVEYOR

FORM APPROVED BY MICHIGAN STATE BOARD OF LAND SURVEYORS, JAN. 26, 1971
REVISED MAY 14, 1975
REVISED JAN., 1983