LAND CORNER RECORDATION CERTIFICATE

Filing Requirement of Act 74, Mich. P.A. 1970

filed 7-24-89 MJW

For corners in MISSAUKEE (County)

	Located In:	Corner Code ##
1. Public Land Survey	T 21N R 5W	E-4
	T ___ R ___	
	T ___ R ___	
	T ___ R ___	
2. Property Controlling	S 9 T ___ R ___	3
in Section	S ___ T ___ R ___	
3. Miscellaneous	S ___ T ___ R ___	
Property in Sec.	S ___ T ___ R ___	

Register of Deeds Stamp & File Number

4. Lot No. _____ , Recorded Plat _____
5. Private Claims _____

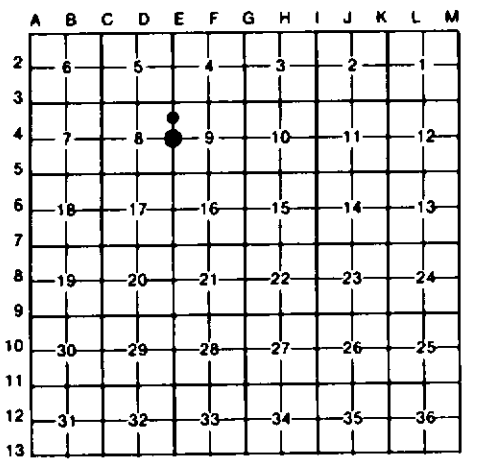

I, CARL F. ROSER, in a field survey on MAY 24, 19 88, do hereby certify that under requirements of P.A. 74, Michigan P.A. of 1970, the corner points mentioned in lines 1 and 2 above were in conformance with regulations and rules therefore as required in the current manual of survey instructions of the United States Department of the Interior, Bureau of Land Management or by a decree of a Court of Law and/or that the corner points mentioned in lines 3, 4 and 5 above were in conformance with the rules of the Michigan Board of Land Surveyors or by a Decree of a Court of Law; established, re-established,. monumented, re-monumented, recovered, found as expressed below:

NOTE: Not more than 4 corners, all in the same town and range, may be recorded on this certificate.

A. Description of original monument and accessories and/or subsequent restoration:

E-4

3

B. Description of corner evidence found and/or method applied in restoring or reestablishing corner:

E-4

RESTORED N 1/4 COR S-9 IN LINE WITH OLD FENCE WEST, & ONE ROD E OF OLD FN S & TWO RODS E OF OLD FN N. THIS FITS E.A.DEUTHIEN 1915 SUR OF S-8. E.A.D. CALLED FOR STONE & PLOW WHEEL, FD POSS. STONE BUT NO PLOW WHEEL.

3

SET SW COR OF NW 1/4 - NW 1/4 OF S-9 PER STANDARD BLM INSTRUCTIONS. FD OLD IR (ODD SHAPE) S14°14'W 1.97' IN APPROX LINE OLD SMALL CED POST FENCE, ALL DOWN, TO E; DID NOT USE SINCE IT'S 1320'± FROM N & WOULD NOT FIT N 1/4 COR S-9 AS ESTABLISHED.

C Description of monument for corner and accessories established to perpetuate locating the position of the corner:

E-4

DROVE 5/8" X 34" REROD W/RLS CAP ON SW SIDE OF FD 6" X 14" STONE.

14" R OAK	N05°E	68.00
32" R OAK	N70°E	72.20
7" B CHERRY	S20°E	57.79
5" R OAK	S35°E	74.84

COR FALLS IN N-S GRAVEL ROAD.

3

DROVE 5/8" X 34" REROD W/RLS CAP.

25" R OAK	N45°W	46.96
28" R OAK	N20°E	55.35
7" R OAK	S30°E	68.97
7" ELM	S20°W	76.69
CTR N-S DIRT RD	DUE E	7'
SET CED POST W/ LOC TAG.	DUE E	33'

STATE OF MICHIGAN
CARL F. ROSER
LAND SURVEYOR
No. 12028
REGISTERED LAND SURVEYOR

Signed by Carl F. Roser 10-25-88 Date _____

Surveyor's Michigan License No. 12028

FORM APPROVED BY MICHIGAN STATE BOARD OF LAND SURVEYORS, JAN. 28, 1971
REVISED MAY 14, 1975
REVISED JAN., 1983