LAND CORNER RECORDATION CERTIFICATE

Filing Requirement of Act 74, Mich. P.A. 1970

For corners in
MISSAUKEE
(County)

Located In: | Corner Code ##

1. Public Land Survey — T 21N R 5W — G-1
   T ___ R ___ — H-1
   T ___ R ___ — H-3
   T ___ R ___
2. Property Controlling — S 3 T ___ R ___ — 15
   in Section — S ___ T ___ R ___
3. Miscellaneous — S ___ T ___ R ___
   Property in Sec. — S ___ T ___ R ___

filed 8/7/89 97 W

Register of Deeds Stamp & File Number

4. Lot No. _____ , Recorded Plat _____
5. Private Claims _____

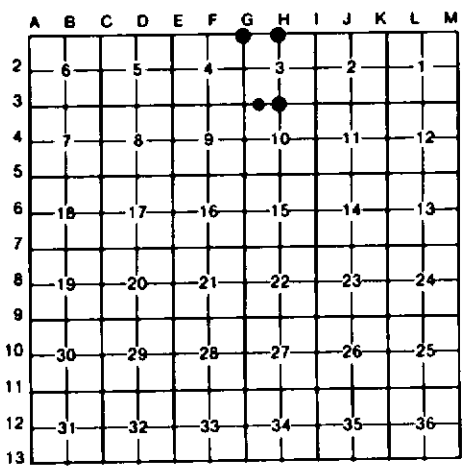

I, CARL F. ROSER, in a field survey on SEPTEMBER 10, 19 87, do hereby certify that under requirements of P.A. 74, Michigan P.A. of 1970, the corner points mentioned in lines 1 and 2 above were in conformance with regulations and rules therefore as required in the current manual of survey instructions of the United States Department of the Interior, Bureau of Land Management or by a decree of a Court of Law and/or that the corner points mentioned in lines 3, 4 and 5 above were in conformance with the rules of the Michigan Board of Land Surveyors or by a Decree of a Court of Law; established, re-established, monumented, re-monumented, recovered, found as expressed below:

NOTE: Not more than 4 corners, all in the same town and range, may be recorded on this certificate.

A. Description of original monument and accessories and/or subsequent restoration:

G-1: FD L.CAVANAGH REROD FOR COR COMMON TO SEC'S 3 & 4, T21N-R5W & SEC'S 33 & 34, T22N-R5W. REPLACED W/ 5/8" REROD. FN COR (FN N & E) IS N 33'.

H-1: FD 1/2" ROD IN GRVL RD INTERSEC FOR N 1/4 COR S-3 (S 1/4 COR S-34,T22N-R5W). THIS ROD HAS BEEN PREV'LY USED BY R.L.S'S J.WILCOX, PAUL LAPHAM, L. CAVANAGH & M.MCCLUNG. AN OLD WAGON SKEIN WAS FD BURIED IN THE GRVL RD S85°05'W, 7.12' FROM THE 1/2" REROD; THE WAGON SKEIN IS PROB'LY PER E.A.BEUTHIEN, 1915.

H-3: FD AND ACCEPTED 1/2" X 18" REROD FOR S 1/4 COR OF S-3 AS ESTAB'D EQUIDISTANT & ON LINE BY R.L.S., L.CAVANAGH IN 1976 SUR & SEC. SUB'N OF S-3.

15: DROVE 5/8"X 34" REROD, PER STD B.L.M. INSTRUCTIONS, FOR SW COR OF SE-SW OF S-3.

B. Description of corner evidence found and/or method applied in restoring or reestablishing corner:

G-1: FD 1/2" X 18" REROD. REPLACED W/ 5/8" X 34" REROD W/RLS CAP.
6" OAK N42°W 33.23'
8" MAPL CLP/4 S50°E 54.47'
12" MAPL CLP/2 S05°W 58.75'
SET CED POST W/LOC TAG S 33'±. IN APPROX CTR OF E-W GR RD.

H-1: FD 1/2" REROD IN GR RD INTERSEC. (N-E-W)
T. POLE N53°E 47.32'
FN POST N58°W 79.91'
FD IR W/RLS CAP SOUTH 33.00'
9" R PINE S26°W 53.53'
9" R PINE S42°W 56.43'

H-3: FD 1/2" X 18" REROD W/RLS CAP #17614; REPL W/DNR MON & SET CED POST.
10" CEDAR N22°E 2.7'
9" CEDAR S88°E 22.2'
9" TW CEDAR S04°E 8.1'
8" CEDAR N30°W 14.6'

15: DROVE 5/8" X 34" REROD W/RLS CAP & SET CED POST W/LOC TAG.
6" MAPLE N52°E 17.1'
6" MAPLE N24°W 12.9'
9" MAPLE S10°W 4.7'

C. Description of monument for corner and accessories established to perpetuate locating the position of the corner:





Signed by Carl F. Roser 10-25-88 Date _____

Surveyor's Michigan License No. 12028

STATE OF MICHIGAN
CARL F. ROSER
LAND SURVEYOR
No. 12028
REGISTERED LAND SURVEYOR

FORM APPROVED BY MICHIGAN STATE BOARD OF LAND SURVEYORS JAN. 1971
REVISED MAR. 14, 1975
REVISED JAN., 1983