LAND CORNER RECORDATION CERTIFICATE
Filing Requirement of Act 74, Mich. P.A. 1970

For corners in
MISSAUKEE
(County)

	Located In:	Corner Code ##
1. Public Land Survey	T 21N R 5W	J-1
	T ___ R ___	
	T ___ R ___	
	T ___ R ___	
2. Property Controlling	S 2 T ___ R ___	1
in Section	S 2 T ___ R ___	4
3. Miscellaneous	S ___ T ___ R ___	
Property in Sec.	S ___ T ___ R ___	

tel 8/7/89

Register of Deeds Stamp & File Number

4. Lot No. _____ , Recorded Plat _____
5. Private Claims _____

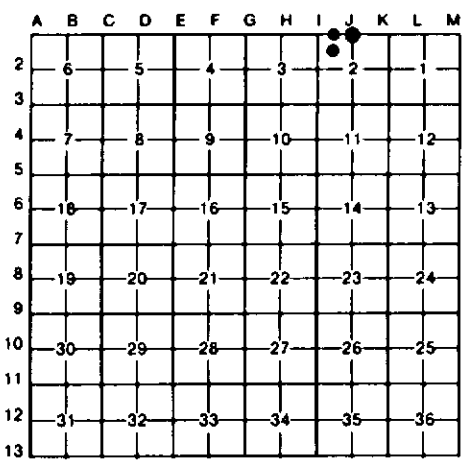

I, CARL F. ROSER, in a field survey on SEPTEMBER 9, 19 87, do hereby certify that under requirements of P.A. 74, Michigan P.A. of 1970, the corner points mentioned in lines 1 and 2 above were in conformance with regulations and rules therefore as required in the current manual of survey instructions of the United States Department of the Interior, Bureau of Land Management or by a decree of a Court of Law and/or that the corner points mentioned in lines 3, 4 and 5 above were in conformance with the rules of the Michigan Board of Land Surveyors or by a Decree of a Court of Law; established, re-established, monumented, re-monumented, recovered, found as expressed below:

NOTE: Not more than 4 corners, all in the same town and range, may be recorded on this certificate.

A. Description of original monument and accessories and/or subsequent restoration:

J-1
1
4
4 (CONT.)

B. Description of corner evidence found and/or method applied in restoring or reestablishing corner:

J-1
PREV COR OF REC (1/4 COR COMM TO S-2,T21N,R5W & S-35,T22N, R5W) AS ESTAB M.P.O.L. BETW NE & NW OF S-2; K.OSTLING, DEPT LAND SURVEYOR, 1967. COR FALLS IN OPEN SWP GRASS AREA; HIGH GRD IS 400'± TO N & S. OLD FN N'LY IS 18'± WEST.

1
DROVE 3/8" X 60" PIPE FOR NW COR OF FRL NE 1/4 OF FRL NW 1/4 OF S-2; PER STD B.L.M INSTRUCTIONS FOR SEC SUB'N. COR FALLS IN OPEN SWP GRASS, TAG ALDER & FEW DEAD STPS; 700'± IN ANY DIR TO HIGH GRD.

4
DROVE 5/8" X 34" REROD FOR SW COR OF FRL NE 1/4 OF FRL NW 1/4 OF S-2 (CTR OF FRL NW 1/4 OF S-2 PER G.L.O.-1852 RESURV); PER STD B.L.M. INSTR FOR SEC SUB'N. THE CTR OF OLD STATE RD (EXIST GRVL RD NW-SE) IS 290'+ N & 250'+ E. A N-S OLD B.WIRE FN ON CED POSTS IS 12.5'W. DROVE A 5/8"X34" REROD W/RLS CAP ON E'LY R.O.W. OF OLD STATE RD (33' AT RT ANGLES

4 (CONT.)
TO CTR LINE) S89°34'45"E, 301.33' FROM CTR NW 1/4, ALONG THE S LINE OF SAID NE-NW S-2. SET CED POST W/LOC TAG ALONG SIDE OF REROD.

C. Description of monument for corner and accessories established to perpetuate locating the position of the corner:

J-1
FD DEPT MON & CED POST, SET NEW CED POST.

*16" ASH	N17°E	34.1'
*10" ELM STP	S89°W	44.9'
5" ASH	N84°E	69.2'
CTR 9'+WIDE STREAM(C-N)	SOUTH	6'±

*KJO 1967 WIT TREES.

1
DROVE 3/8" X 60" PIPE W/RLS CAP & SET CED POST W/LOC TAG.

11" DEAD ELM	S48°W	38.4'
8" ELM (LEANS E'LY)	N03°E	19.3'

NO OTHER WITNESSES AVAILABLE.

4
DROVE 5/8"X34" REROD W/RLS CAP & SET CED POST W/LOC TAG.

12" MAPLE	N60°E	10.5'
10" CHERRY	S18°E	17.2'
12" OAK	S22°W	46.4'

4 (CONT.)

Signed by Carl F. Roser 10-25-88 Date _____

Surveyor's Michigan License No. 12028

STATE OF MICHIGAN
CARL F. ROSER
LAND SURVEYOR
No. 12028
REGISTERED LAND SURVEYOR

FORM APPROVED BY MICHIGAN STATE BOARD OF LAND SURVEYORS, JAN. 28, 1971
REVISED MAY 14, 1975
REVISED JAN., 1983