LAND CORNER RECORDATION CERTIFICATE

Filing Requirement of Act 74, Mich. P.A. 1970

For corners in
MISSAUKEE
(County)

	Located In:	Corner Code ##
1. Public Land Survey	T 21N R 5W	L-3
	T ___ R ___	M-3
	T ___ R ___	I-2
	T ___ R ___	
2. Property Controlling	S ___ T ___ R ___	
in Section	S ___ T ___ R ___	
3. Miscellaneous	S ___ T ___ R ___	
Property in Sec.	S ___ T ___ R ___	

filed 8/16/90

Register of Deeds Stamp & File Number

4. Lot No. _____ , Recorded Plat _____
5. Private Claims _____

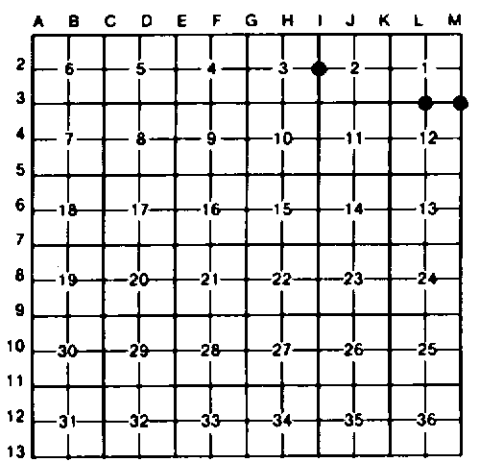

I, CARL F. ROSER , in a field survey on AUGUST 4, , 19 87 , do hereby certify that under requirements of P.A. 74, Michigan P.A. of 1970, the corner points mentioned in lines 1 and 2 above were in conformance with regulations and rules therefore as required in the current manual of survey instructions of the United States Department of the Interior, Bureau of Land Management or by a decree of a Court of Law and/or that the corner points mentioned in lines 3, 4 and 5 above were in conformance with the rules of the Michigan Board of Land Surveyors or by a Decree of a Court of Law; established, re-established, monumented, re-monumented, recovered, found as expressed below:

NOTE: Not more than 4 corners, all in the same town and range, may be recorded on this certificate.

A. Description of original monument and accessories and/or subsequent restoration:

L-3

M-3

M-3 (CONT)

I-2

B. Description of corner evidence found and/or method applied in restoring or reestablishing corner:

L-3

FD 2" PIPE FOR S 1/4 COR OF S-1; FITS TWO TEED NITS. SEE TEED SUR FOR RD FOR TWP RD COMM., SEPT 9, 1900; NOTES IN F.B.125, PGS 30 & 31 AT GOURDIE,FRASER & ASSOC., TRV. CITY. COR FALLS AT S EDGE OF OLD E-W RD GRADE, MOSTLY OVER-GROWN.

M-3

RESTORED SE COR OF S-1 FROM THREE "TEED" N.B.T'S (W PINE STUMPS-STILL STANDING); WHICH FITS "TEEDS" DISTANCES 1/2 MI & 1 MI W TO FD MON ALMOST EXACTLY. "TEEDS" SUR ALONG THE S LINE OF S-1 FOR TWP RD COMM. (SEPT 9, 1900), IS RECORDED IN HIS BK 125, PGS 30.

M-3 (CONT)

& 31; SAID NOTES IN POSSESSION OF GOURDIE,FRASER & ASSOC., TRV. CITY. PORTIONS OF THIS OLD TWP RD GRADE ARE STILL EVIDENT ALONG PARTS OF THE S LINE OF S-1. TEEDS NOTES SAY HE HAD U.S.B.T'S.

I-2

FD SQ CED POST AS SET BY DEPT LAND SUR, KJD IN 1961 FROM 1907, CD SURVEYOR J.D.MCBAIN NIT; WHICH IS STILL EVIDENT. COR HAS BEEN USED BY RLS, BILL BATZER IN 1964 SUR OF PART OF THE NW 1/4 OF S-2 & IN 1976 SUR & SEC SUB'N OF S-3 BY RLS, L. CAVANAGH.

C. Description of monument for corner and accessories established to perpetuate locating the position of the corner:

L-3

FD 2" PIPE & SET CED POST W/LOC TAG.

10" CEDAR	N22°W	19.9'
12" MAPLE	N70°E	24.6'
8" CEDAR	S40°E	23.1'
10" CEDAR	S55°W	13.6'

M-3

SET DNR MON & CED POST.

4" R PINE	N42°E	10.9'
10" R OAK	S30°E	39.3'
9" R OAK	S54°W	30.8'
8" TW MAPL	N18°W	3.4'
*24" W.P.STP	N29°E	17.2'
*30" W.P.STP	S58°W	33.0'
*24" W.P.STP	S23°W	28.1'

M-3 (CONT)

*EQUALS TEEDS 1900 N.B.T'S.

I-2

FD SQ CED POST. REPLACED W/DNR MON & NEW CED POST.

*12" W.P.STP	N70°W	12.6'
8" MAPLE	N74°E	17.7'
7" MAPLE	S30°E	16.8'
6" MAPLE	S20°W	16.0'
11" CEDAR	N22°W	21.8'

*MCBAIN NIT 1907

Signed by Carl F. Roser 10-25-88 Date _____

Surveyor's Michigan License No. 12028

STATE OF MICHIGAN
CARL F. ROSER
LAND SURVEYOR
12028
REGISTERED LAND SURVEYOR

FORM APPROVED BY MICHIGAN STATE BOARD OF LAND SURVEYORS JAN. 28, 1971
REVISED MAY 14, 1971
REVISED JAN. 1, 1973