LAND CORNER RECORDATION CERTIFICATE

Filing Requirement of Act 74, Mich. P.A. 1970

For corners in
MISSAUKEE
(County)

	Located In:	Corner Code #1
1. Public Land Survey	T 21N R 5W	K-1
	T ____ R ____	L-1
	T ____ R ____	M-1
	T ____ R ____	M-2
2. Property Controlling	S ____ T ____ R ____	
in Section	S ____ T ____ R ____	
3. Miscellaneous	S ____ T ____ R ____	
Property in Sec.	S ____ T ____ R ____	

Register of Deeds Stamp & File Number

4. Lot No. _____ , Recorded Plat _____
5. Private Claims _____

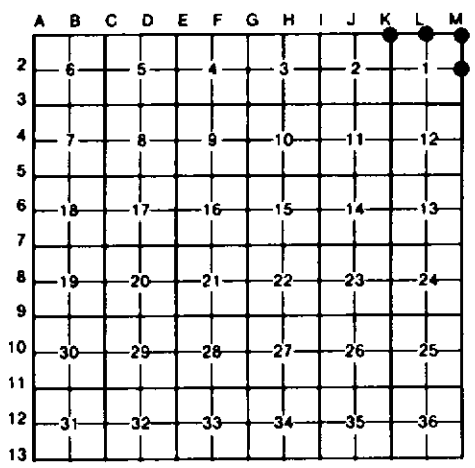

I, CARL F. ROSER, in a field survey on MAY 24, 19 88, do hereby certify that under requirements of P.A. 74, Michigan P.A. of 1970, the corner points mentioned in lines 1 and 2 above were in conformance with regulations and rules therefore as required in the current manual of survey instructions of the United States Department of the Interior, Bureau of Land Management or by a decree of a Court of Law and/or that the corner points mentioned in lines 3, 4 and 5 above were in conformance with the rules of the Michigan Board of Land Surveyors or by a Decree of a Court of Law; established, re-established, monumented, re-monumented, recovered, found as expressed below:

NOTE: Not more than 4 corners, all in the same town and range, may be recorded on this certificate.

A. Description of original monument and accessories and/or subsequent restoration:

K-1

L-1

M-1

M-2

B. Description of corner evidence found and/or method applied in restoring or reestablishing corner:

K-1

FD DEPT MON FOR NW COR S-1 AS SET BY K.J.OSTLING IN 1962 DEPT SUR. KJO FD OLD SQUARED CED POST, BELIEVED TO BE M. SCHAAF'S COR.; SCHAAF SET COR FROM FOUND U.S. B.T.'S.

L-1

FD M. SCHAAF 1 1/2" PIPE & 2 1/2" X 24" SQ. ROTTED-OFF CED POST (&POINT IN MUCK) FOR N 1/4 COR S-1. FD HUMMOCKS THAT WOULD FIT 2-POSS. E.A.DEUTHIEN & 1 U.S.B.T WITS.

M-1

RESTORED 4 TWP COR'S ON LINE & PRORATED DIST. TO M.SCHAAF ACROSS FD NW & N 1/4 COR'S OF S-1. COULD NOT FIND ANY OLD WITS (U.S., BELKNAP, DEUTHIEN, OR SCHAAF). FD OLD 2" X 36" PIPE LYING FLAT UNDER MUCK, S10 W, 10.3'±; BUT COULD NOT TELL WHERE IT CAME FROM (LAID SAID PIPE ALONGSIDE OUR MON.)

M-2

RESTORED E 1/4 COR S-1 AT PRORATED DIST. TO U.S.-GLO 1836 SURVEY & ON LINE BETWEEN RESTORED SE & NE COR'S OF S-1.

C. Description of monument for corner and accessories established to perpetuate locating the position of the corner:

K-1

FD CONS. DEPT MON; SET CED POST.

*13" CEDAR	N22°W	63.0'
8" CEDAR	N88°E	52.2'
5" CEDAR	S56°W	22.5'
12" MAPLE	N80°W	100.3'
FD OLD 3/4" PIPE	N61°W	16.6'

*FD KJO WIT.

L-1

FD 1 1/2" X 3 1/2' PIPE; DROVE 1" X 8' GALV PIPE W/DNR ALUM CAP INSIDE & SET CEDAR POST.

10" CEDAR	N75°W	19.5'
9" TAMARACK	N35°E	40.2'
9" CEDAR	S60°E	10.4'
8" CEDAR	S20°W	4.8'

M-1

SET 1" X 5' GALV PIPE W/ALUM CAP; SET CED POST.

6" CEDAR	N60°W	20.1'
10" CEDAR	N45°E	8.5'
8" CEDAR	S15°E	7.5'
9" CEDAR	S60°W	27.2'
E'LY EDGE CED SWAMP	EAST	75'±6'

M-2

SET DNR MON & CED POST.

7" OAK	N15°W	42.9
11" TRIPLE MAPL	N30°E	42.0
2" W PINE	S10°W	47.8
15" MAPLE	S35°W	48.1
S'LY EDGE WILLOW SWAMP	DUE N	151'±15'

Signed by Carl F. Roser 10-25-88 Date _____

Surveyor's Michigan License No. 12028

STATE OF MICHIGAN CARL F. ROSER LAND SURVEYOR No. 12028 REGISTERED LAND SURVEYOR

FORM APPROVED BY MICHIGAN STATE BOARD OF SURVEYORS, JUNE 26, 1971 REVISED MARCH 1975 REVISED JAN. 1983