

LAND CORNER RECORDATION CERTIFICATE
Filing Requirement of Act 74, Mich. P.A. 1970

For corners in
MISSAUKEE
 (County)

Located In: _____ Corner Code #/

- | | | |
|------------------------------------|-----------------------------|-------------------|
| 1. Public Land Survey | T <u>21N</u> R <u>5W</u> | <u>B-13, H-13</u> |
| | T _____ R _____ | <u>I-13</u> |
| | T _____ R _____ | _____ |
| | T _____ R _____ | _____ |
| 2. Property Controlling in Section | S <u>34</u> T _____ R _____ | <u>15</u> |
| | S _____ T _____ R _____ | _____ |
| 3. Miscellaneous Property in Sec. | S _____ T _____ R _____ | _____ |
| | S _____ T _____ R _____ | _____ |

Register of Deeds Stamp & File Number


4. Lot No. _____, Recorded Plat _____
 5. Private Claims _____

I, CARL F. ROSER, in a field survey on FEBRUARY 20, 19 90, do hereby certify that under requirements of P.A. 74, Michigan P.A. of 1970, the corner points mentioned in lines 1 and 2 above were in conformance with regulations and rules therefore as required in the current manual of survey instructions of the United States Department of the Interior, Bureau of Land Management or by a decree of a Court of Law and/or that the corner points mentioned in lines 3, 4 and 5 above were in conformance with the rules of the Michigan Board of Land Surveyors or by a Decree of a Court of Law; established, re-established, monumented, re-monumented, recovered, found as expressed below:

NOTE: Not more than 4 corners, all in the same town and range, may be recorded on this certificate.

A. Description of original monument and accessories and/or subsequent restoration:
 6-13 H-13 I-13

A	B	C	D	E	F	G	H	I	J	K	L	M
2	6	5	4	3	2	1						
3												
4	7	8	9	10	11	12						
5												
6	18	17	16	15	14	13						
7												
8	19	20	21	22	23	24						
9												
10	30	29	28	27	26	25						
11												
12	31	32	33	34	35	36						
13												

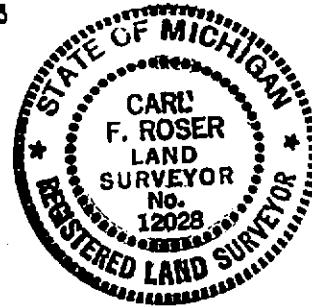

B. Description of corner evidence found and/or method applied in restoring or reestablishing corner:

- | | | | |
|---|--|--|---|
| 6-13
FD PIPE FOR SE COR SEC 33 AS FD & WITNESSED BY J. WILCOX IN 1974 SURVEY FOR MISSAUKEE CO. RD COMM. J. WILCOX NOTES SHOW COR FITS E.A. BEUTHIEN SURVEY WORK ON 2ND CORRECTION LINE. COR IS IN LINE W/CTR OF ABANDONED CO. RD TO N & E. | H-13
ACCEPTED FD WELL POINT FOR S 1/4 COR SEC 34. COR IS BURIED AT N EDGE E-W GRAVEL RD. FITS 1938 M. SCHAAF DATA 1/2 MILE TO WEST. | I-13
FD M. SCHAAF CONC MON FOR SW COR SEC 35. CTR OF N-S SAND RD IS 7' E. SAND RD INTER (RDS N-E-W-SW'LY-NE'LY) IS 7' E & 8' + S. | 15
DROVE 5/1" REROD FOR SW COR OF SE 1/4 OF SW 1/4 OF SEC 34, PER STANDARD BLM INSTRUCTIONS. CTR E-W 16' WIDE DIRT RD IS 3' SOUTH. |
|---|--|--|---|

C. Description of monument for corner and accessories established to perpetuate locating the position of the corner:

- | | | | |
|--|---|---|---|
| 6-13
FD 3/8" X 14" PIPE, REPLACED W/5/8" X 34" REROD W/RLS CAP & SET CED POST W/LOC TAB.
10" OAK N55°W 38.46'
#15" OAK N35°W 48.86'
#19" OAK N30°E 52.85'
#10" MAPLE W/
6" MAPLE 880°W 45.70' | H-13
FD 1 1/4" WELL POINT, ADDED 5/8" X 34" REROD W/RLS CAP.
13" R PINE N50°W 55.4'
13" W OAK N20°E 30.1'
10" OAK 820°E 36.1'
12" OAK (CLP 4) 830°W 53.6'
SET CED POST W/
LOC TAB. DUE N 33' | I-13
FD 1 1/2" SHORT PIPE IN 6"X6" X6" CONC BLK, ADDED 5/8" X 34" REROD W/RLS CAP. & SET CEDAR POST W/LOC TAB.
7" R PINE N30°E 50.3'
7" R PINE N60°E 50.2'
6" J PINE N25°W 30.6'
FD 1 1/4" PIPE S00°05'W 87.16'
FD 1 1/2" PIPE S58°11'W 60.54' | 15
DR 5/8" X 34" REROD W/RLS CAP.
26" OAK N40°W 43.3'
6" J PINE N22°E 52.3'
11" B CHERRY S65°W 73.3'
CTR N END 12" CMP
X-CULV N40°W 19.7'
NW COR 8-3
T20N R5W N89°22'W 504.13'
SET CED POST
W/LOC TAB. DUE N 33' |
|--|---|---|---|

#LLS JERRY WILCOX WIT.

Signed by Carl F. Roser 12028 5-22-92 Date _____

Surveyor's Michigan License No. _____