

APR 09 2010

LAND CORNER RECORDATION CERTIFICATE

Filing Requirement of Act 74, Mich. PA 1970

For Corners In:

Missaukee
(County)

Located In

Corner Code #

1. Public Land Survey	T	<u>21N</u>	R	<u>5W</u>	<u>1-9</u>
	T	_____	R	_____	_____
2. Property Controlling in Section	S	_____	T	_____	R
	S	_____	T	_____	R
3. Miscellaneous Property in Section	S	_____	T	_____	R
	S	_____	T	_____	R


Register of Deeds Stamp & File Number

4. Lot No: _____ Recorded Plat: _____

5. Private Claims: _____

I, Craig W. McVean, in a field survey on March 15, 2010 do hereby state that under requirements of PA 74, Michigan PA of 1970, the corner points mentioned in lines 1 and 2 above were in conformance with regulations and rules therefore as required in the current manual of survey instructions of the United States Department of the Interior, Bureau of Land Management or by a decree of a Court of Law and/or that the corner points mentioned in lines 3, 4 and 5 above were in conformance with the rules of the Michigan Board of Land Surveyors or by a Decree of a Court of Law; established, re-established, monumented, recovered, found as expressed below:

NOTE: Not more than 2 corners, all in the same town and range, may be recorded on this certificate.

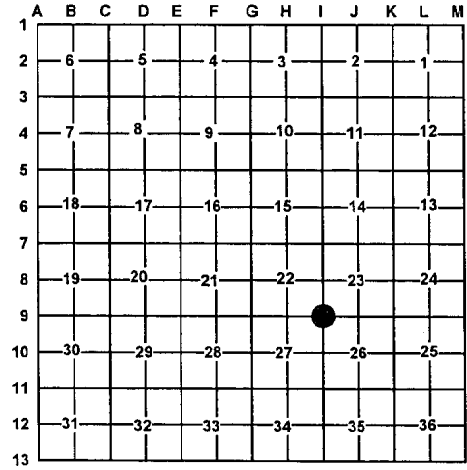

A. Description of original monument and accessories and/or subsequent restoration:

- 1-9 - 1852 - A. Curtis - Set Post
 - 1) W. Pine 24" S42°W 55 L.
 - 2) W. Pine 24" N56°E 53 L.
- 1915 - CSR - FB #39, p. 71 & 79 - OB OK -
 - 3) Oak 5" West 42 (OB Remarkd)
- 1939 - M. Schaaf - Block Set. NE Stub & SW Bottom

- 1967 - LCRC #501 - DNR Cor. Record - K. J. Ostling - Fd. Pipe as established in early survey by Marcus Schaaf. Possible BT Stps. in place and appears to fit other corners in area. Set Cons. Dept. Mon.
 - 4) 15" Oak S58°W 12.2'
 - 5) 14" Oak S2°E 16.7'

B. Description of corner evidence found and/or method applied in restoring or re-establishing corner:

1-9 - Section corner common to Sections 22, 23, 26, & 27, T21N, R5W - Fd. 4" DOC Alum. Cap on 1" iron pipe per Ostling. Also found 1 1/2" I.D. iron pipe on SW side of DOC monument. Measured N49°E 34.4' to axed notch at base of 24"± WPS for Witness #2. At location of Witness #1 found remains of Pine Stp. to ground. Measured West 27.4' to centerline of 20" Oak Stp. for witness #3. Both of Ostling's witnesses in place. N20°W 25' to centerline of 2-track to W. and NE. DOC Mon. accepted as a careful and faithful perpetuation of the position of the original corner.

C. Description of monument for corner and accessories established to perpetuate locating the position of the corner:

- 1-9 - 4" Dept. of Conservation Alum. Cap on 1" galv. iron pipe. Add Ring of Stones. Set Blue Carsonite Post 1' SW.
 - S70°W 12.60' to set N & T in N. side 20" Oak (#4)
 - S3°E 17.08' to set N & T in E. side 26" Oak (#5)
 - S52°E 33.71' to set N & T in NE side 15" W. Oak
 - N55°E 22.87' to set N & T in NW side 5" Oak
 - N18°W 42.92' to set N & T in W. side 3" W. Pine



Signed by: Craig W. McVean
Surveyor's Michigan License No.: 39088

Date: 4/5/2010