LAND CORNER RECORDATION CERTIFICATE

Filing Requirement of Act 74, Mich. P.A. 1970

For corners in
MISSAUKEE
(County)

	Located In:	Corner Code ##
1. Public Land Survey	T 21N R 6W	L-11
	T ___ R ___	
	T ___ R ___	
	T ___ R ___	
2. Property Controlling	S 36 T ___ R ___	1
in Section	S ___ T ___ R ___	
3. Miscellaneous	S ___ T ___ R ___	
Property in Sec.	S ___ T ___ R ___	

Register of Deeds Stamp & File Number

4. Lot No. _____ , Recorded Plat _____
5. Private Claims _____

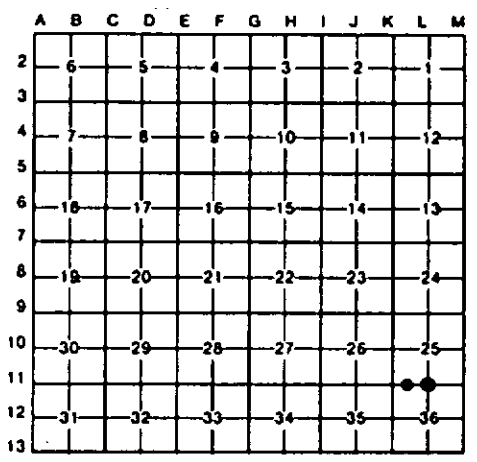

I, CARL F. ROSER, in a field survey on DECEMBER 9, 19 91, do hereby certify that under requirements of P.A. 74, Michigan P.A. of 1970, the corner points mentioned in lines 1 and 2 above were in conformance with regulations and rules therefore as required in the current manual of survey instructions of the United States Department of the Interior, Bureau of Land Management or by a decree of a Court of Law and/or that the corner points mentioned in lines 3, 4 and 5 above were in conformance with the rules of the Michigan Board of Land Surveyors or by a Decree of a Court of Law; established, re-established, monumented, re-monumented, recovered, found as expressed below:

NOTE: Not more than 4 corners, all in the same town and range, may be recorded on this certificate.

A. Description of original monument and accessories and/or subsequent restoration:

L-11

1

B. Description of corner evidence found and/or method applied in restoring or reestablishing corner:

L-11

REESTAB'D S 1/4 COR OF SEC 25 MIDWAY & ON LINE BETWEEN SE & SW SEC COR'S. E'LY EDGE MARSH IS 40'(± 15') WEST AND 140'(± 20') NORTH. COR FALLS IN 2 ACRE ± CLEAR CUT. OLD FN POST AND NEWER YELLOW TOP STEEL POSTS ACROSS MARSH, BEARING N'LY, ARE 24'(± 2') NORTH. NO EVID OF FN COR.

1

ESTABLISHED NW COR OF NE 1/4 OF NW 1/4 OF SEC 36 PER GTD BLM INSTRUCTIONS. COR FALLS ON E'LY EDGE SWP. CTR 14' ± WIDE CREEK IS 374'(± 6') WEST.

C. Description of monument for corner and accessories established to perpetuate locating the position of the corner:

L-11

SET DNR MON & CED POST

14" W BIRCH	N20°W	93.56'
13" OAK	S15°E	192.38'
10" TWIN OAK	S15°W	158.55'

1

DROVE 5/8" X 34" REROD W/RLS CAP. SET CED POST W/LOC TAG.

9" TW TAMARACK	N45°W	42.4'
8" TW B CHERRY	N75°E	40.9'
7" SPRUCE	S35°E	14.1'
6" TW SPRUCE	S75°W	19.0'

Signed by Carl F. Roser 12028 Date 12-02-92

Surveyor's Michigan License No. _____

FORM APPROVED BY MICHIGAN STATE BOARD OF LAND SURVEYORS, JAN. 28, 1971
REVISED MAY 14, 1975
REVISED JAN., 1983