

**LAND CORNER RECORDATION CERTIFICATE**  
Filing Requirement of Act 74, Mich. P.A. 1970

For corners in  
MISSAUKEE  
(County)

Located In: \_\_\_\_\_ Corner Code ~~##~~

1. Public Land Survey	T <u>21N</u> R <u>4W</u>	<u>1-13, J-13,</u>
	T _____ R _____	<u>K-13</u>
	T _____ R _____	_____
	T _____ R _____	_____
2. Property Controlling in Section	S <u>35</u> T _____ R _____	<u>16</u>
	S _____ T _____ R _____	_____
3. Miscellaneous Property in Sec.	S _____ T _____ R _____	_____
	S _____ T _____ R _____	_____

Register of Deeds Stamp & File Number


4. Lot No. \_\_\_\_\_, Recorded Plat \_\_\_\_\_  
5. Private Claims \_\_\_\_\_

I, CARL F. ROSER, in a field survey on JANUARY 29, 19 92, do hereby certify that under requirements of P.A. 74, Michigan P.A. of 1970, the corner points mentioned in lines 1 and 2 above were in conformance with regulations and rules therefore as required in the current manual of survey instructions of the United States Department of the Interior, Bureau of Land Management or by a decree of a Court of Law and/or that the corner points mentioned in lines 3, 4 and 5 above were in conformance with the rules of the Michigan Board of Land Surveyors or by a Decree of a Court of Law; established, re-established, monumented, re-monumented, recovered, found as expressed below:

**NOTE:** Not more than 4 corners, all in the same town and range, may be recorded on this certificate.

A. Description of original monument and accessories and/or subsequent restoration:

1-13                              J-13                              K-13                              16

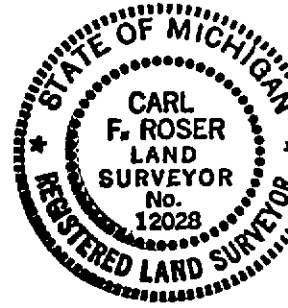

B. Description of corner evidence found and/or method applied in restoring or reestablishing corner:

<u>1-13</u> ACCEPTED FD 5/8" ROD W/RLS CAP #13037 FOR SW COR SEC 35. N. McCLUNG REESTAB'D THIS COR ON N BOUNDARY OF A SURVEY BY P. LAPHAM AND FALLS IN OLD E-W FM ROW. OLD FM N 16 121' EAST. WEST EDGE CLAM RIVER IS 349' ± 3' EAST.	<u>J-13</u> REESTAB'D S 1/4 COR SEC 35 AT INTERSEC OF TWP LINE BETN FD NW SEC 2, T20N-R6W & REESTAB'D SE COR SEC 35, T21N-R6W AND N-S 1/4 LINE OF SEC 35, BETN REESTAB'D N 1/4 SEC 35 AND A COMP PT MIDWAY & ON LINE BETN FD SW SEC 35 & REESTAB'D SE COR SEC 35, T21N-R6W. COR IS IN 1 1/2' ± OF WATER/MUCK. IN WAIST HIGH WILLOW AND OSIER BRUSH.	<u>K-13</u> REESTAB'D SE COR OF SEC 35. ON LINE BETWEEN FD NW SEC 2, T20N-R6W AND CALC SE S-36, T21N-R6W AND EQUIDISTANT BETN FD SW COR OF SEC 35 AND CALC SE COR OF SEC 36.	<u>16</u> ESTABLISHED SE COR OF W 1/2 OF SE 1/4 OF SEC 35 PER STANDARD BLM INSTRUCTIONS. COR FALLS IN 2' ± OF WATER/MUCK IN WILLOW, OSIER BRUSH SWP. (A FEW SMALL, DEAD, CEDARS THIS AREA.)
--	--	---	--

C. Description of monument for corner and accessories established to perpetuate locating the position of the corner:

<u>1-13</u> FD 5/8" IRON ROD W/RLS CAP; ADDED CED POST W/LDC TAG. *13" MAPLE CLP N75°E 204.65' *22" MAPLE CLP N85°E 234.55' NW COR POLE BLDG. 680°E 143.5' POWER POLE 830°W 95.06'	<u>J-13</u> DROVE 1" X 108" GALV PIPE W/ ALUM DNR CAP. DROVE CED POST.  COR FALLS IN OPEN WILLOW MARSH AND SWAMP; NO AVAILABLE WITS.	<u>K-13</u> DROVE 1" X 96" GALV PIPE W/ ALUM DNR CAP. DROVE CED POST.  CTR N-S WINDING TRAIL ON STRIP OF HIGH GRD WEST 1035' ± N'LY EDGE OF SWAMP WEST 525' ±	<u>16</u> DROVE 1" X 96" GALV PIPE W/RLS CAP; DROVE CED POST W/LDC TAG.  CTR N-S TRAIL RD (ON NARROW RIDGE OF HIGH GRD) EAST 262' EAST EDGE OF SWP EAST 187'
---	---	--	---

\*RLS N. McCLUNG WITS.

NO OTHER WITS AVAILABLE.

NO AVAILABLE WIT.

Signed by Carl F. Roser 12028

Date 12-02-92

Surveyor's Michigan License No. \_\_\_\_\_