

LAND CORNER RECORDATION CERTIFICATE
Filing Requirement of Act 74, Mich. P.A. 1970

For corners in
MISBAUKEE
 (County)

Located In: _____ Corner Code #/

- | | | |
|------------------------------------|-----------------------------|-------------|
| 1. Public Land Survey | T <u>21N</u> R <u>4W</u> | <u>1-12</u> |
| | T _____ R _____ | _____ |
| | T _____ R _____ | _____ |
| | T _____ R _____ | _____ |
| 2. Property Controlling in Section | S <u>35</u> T _____ R _____ | <u>3, 5</u> |
| | S _____ T _____ R _____ | _____ |
| 3. Miscellaneous Property in Sec. | S _____ T _____ R _____ | _____ |
| | S _____ T _____ R _____ | _____ |

Register of Deeds Stamp & File Number

4. Lot No. _____, Recorded Plat _____
 5. Private Claims _____

	A	B	C	D	E	F	G	H	I	J	K	L	M
2	6	5	4	3	2	1							
3													
4	7	8	9	10	11	12							
5													
6	18	17	16	15	14	13							
7													
8	19	20	21	22	23	24							
9													
10	30	29	28	27	26	25							
11													
12	31	32	33	34	35	36							
13													

I, CARL F. ROSE, in a field survey on JULY 22, 19 91, do hereby certify that under requirements of P.A. 74, Michigan P.A. of 1970, the corner points mentioned in lines 1 and 2 above were in conformance with regulations and rules therefore as required in the current manual of survey instructions of the United States Department of the Interior, Bureau of Land Management or by a decree of a Court of Law and/or that the corner points mentioned in lines 3, 4 and 5 above were in conformance with the rules of the Michigan Board of Land Surveyors or by a Decree of a Court of Law; established, re-established, monumented, re-monumented, recovered, found as expressed below:

NOTE: Not more than 4 corners, all in the same town and range, may be recorded on this certificate.

A. Description of original monument and accessories and/or subsequent restoration:


1-12	3	5
------	---	---

B. Description of corner evidence found and/or method applied in restoring or reestablishing corner:

1-12	3	5
FD 5/8" IRON FOR W 1/4 COR SEC 35 AS ESTABLISHED BY N. McCLUNG IN 1983 (SET MIDWAY & ON LINE BETW SEC COR'S TO N & S.) OLD N-S FM REMAINS ARE 70' ± 2' E. N-S WINDING TRAIL IS 110' ± E. CTR OF DRIVENWAY TO N IS 15' N.	ESTABLISHED NW COR OF SW 1/4 OF NW 1/4 OF SEC 35 PER STANDARD BLM INSTRUCTIONS. CTR N-S TRAIL IS 200' E. EAST EDGE OF CLAM RIVER IS 306' ± 5' WEST. OLD N-S FM REMAINS (ON GRD) ARE 117' (± 3') EAST.	ESTABLISHED NW COR OF SW 1/4 OF NE 1/4 OF SEC 35 PER STANDARD BLM INSTRUCTIONS.

C. Description of monument for corner and accessories established to perpetuate locating the position of the corner:

1-12	3	5
FD 5/8" X 18" IRON ROD W/RLS CAP; ADDED DNR MON & CED POST.	DR 3/8" X 54" GALV PIPE W/RLS CAP; SET CED POST W/LDC TAG.	DROVE 5/8" X 34" REROD W/LS CAP & SET CED POST W/LDC TAG.
8" BALSAM N25°W 37.66'	7" TW MAPLE N35°W 1.8'	11" OAK 614°E 20.4'
6" GAS VALVE #60-5 N50°E 117.1'	3" W PINE N60°E 33.3'	8" TRPL MAPLE S42°W 66.4'
6" RD TREATED WOOD (N GATE POST) N75°E 71.31'	6" CEDAR S60°E 38.2'	2" BALSAM N20°W 63.4'
7" BALSAM S82°W 14.69'	11" MAPLE (CLP3) S35°E 16.6'	17" TW OAK N16°E 67.6'

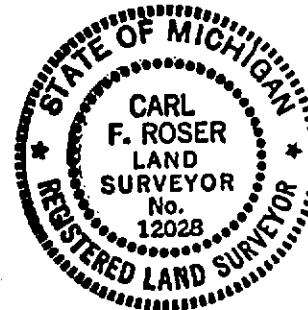

Signed by Carl F. Roser 12028 Date 12-02-92

Surveyor's Michigan License No. _____