

**SURVEY &
REMONUMENTATION**

LIBER 291 PAGE 429

APR 24 1995

978

**LAND CORNER RECORDATION CERTIFICATE
Filing Requirement of Act 74, Mich. P.A. 1970**

COMMISSION

For corners in

	<u>Missaukee</u> (County)	Located In:	Corner Code #
1. Public Land Survey		21N 6W	D-13
		T ___ R ___	___
		T ___ R ___	___
		T ___ R ___	___
		T ___ R ___	___
2. Property Controlling in Section	S ___ T ___	R ___	___
	S ___ T ___	R ___	___
3. Miscellaneous Property in Sec.	S ___ T ___	R ___	___
	S ___ T ___	R ___	___

MISSAUKEE COUNTY MICHIGAN

RECORDED JAN 23 1995 12:01 PM

Paulyn Flare
REGISTER
Register of Deeds Stamp & File Number

4. Lot No. _____, Recorded Plat _____
5. Private Claims _____

	A	B	C	D	E	F	G	H	I	J	K	L	M
2	6	5	4	3	2	1							
3													
4	7	8	9	10	11	12							
5													
6	18	17	16	15	14	13							
7													
8	19	20	21	22	23	24							
9													
10	30	29	28	27	26	25							
11													
12	31	32	33	34	35	36							
13													

I, Daniel E. Schripsema a field surveyor on December, 19 94, do hereby certify that under requirements of P.A. 74, Michigan P.A. of 1970, the corner points mentioned in lines 1 and 2 above were in conformance with regulations and rules therefore as required in the current manual of survey instructions of the United States Department of the Interior, Bureau of Land Management or by a decree of a Court of Law and/or that the corner points mentioned in lines 3, 4 and 5 above were in conformance with the rules of the Michigan Board of Land Surveyors or by a Decree of a Court of Law; established, re-established, monumented, re-monumented, recovered, found as expressed below:

NOTE: Not more than 4 corners, all in the same town and range, may be recorded on this certificate.

A. Description of original monument and accessories and/or subsequent restoration:

- D-13) 1837 GLO post by John Brink, Deputy Surveyor
Maple 12 N 6 W 25, W.Pine 16 N 55 E 39
- D-13) 1989 N. Livasy LCRC Liber 1, page 809:
Set 1/2" rebar w/cap #31611
Power Pole, N 44 W 47.72'
N.E. Barn Cor., S 7 W 201.6'
Service Pole, S 36 E 44.35'

B. Description of corner evidence found and/or method applied in restoring or reestablishing corner:


- D-13) Quarter corner common to Section 32 and Clare County
Found 1/2" Iron w/cap per Liber 1, page 809 and is accepted as a careful and faithful reestablishment of the position of the original corner.

C. Description of monument for corner and accessories established to perpetuate locating the position of the corner:

- D-13) Set Missaukee County monument on existing Iron
 - N 46 W 47.69' P.Pole
 - S 38 E 44.30' Service Pole
 - S 05 W 201.45' NE Cor. Barn
 - S 14 W 110.27' P.Pole

Peer Group Reviewed and Approved
Date: 11-30-94
J. Dean Geers
J. Dean Geers, Missaukee Co. Representative

Signed by *D. E. Schripsema*
Surveyor's Michigan License No. 24617

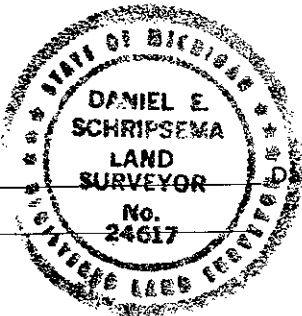

Date 12-30-94