

SURVEY & REMONUMENTATION

LIBER 291 PAGE 428

APR 24 1995

977

LAND CORNER RECORDATION CERTIFICATE
Filing Requirement of Act 74, Mich. P.A. 1970

For corners of **COMMISSION**

_____	<u>Missaukee</u> (County)	Located In:	Corner Code #
1. Public Land Survey	T _____ R _____	<u>21N 6W</u>	<u>E-13</u>
	T _____ R _____		
	T _____ R _____		
	T _____ R _____		
2. Property Controlling in Section	S _____ T _____ R _____		
	S _____ T _____ R _____		
3. Miscellaneous Property in Sec.	S _____ T _____ R _____		
	S _____ T _____ R _____		

MISSAUKEE COUNTY MICHIGAN

RECORDED JAN 23 1995 12:46 PM

Carlynn Flare
REGISTERED

Register of Deeds Stamp & File Number

4. Lot No. _____, Recorded Plat _____
5. Private Claims _____

	A	B	C	D	E	F	G	H	I	J	K	L	M
2	6		5		4		3		2		1		
3													
4	7		8		9		10		11		12		
5													
6	18		17		16		15		14		13		
7													
8	19		20		21		22		23		24		
9													
10	30		29		28		27		26		25		
11													
12	31		32		33		34		35		36		
13													

I, _____, in a field survey on _____, 19_____, do hereby certify that under requirements of P.A. 74, Michigan P.A. of 1970, the corner points mentioned in lines 1 and 2 above were in conformance with regulations and rules therefore as required in the current manual of survey instructions of the United States Department of the Interior, Bureau of Land Management or by a decree of a Court of Law and/or that the corner points mentioned in lines 3, 4 and 5 above were in conformance with the rules of the Michigan Board of Land Surveyors or by a Decree of a Court of Law; established, re-established, monumented, re-monumented, recovered, found as expressed below:

NOTE: Not more than 4 corners, all in the same town and range, may be recorded on this certificate.

A. Description of original monument and accessories and/or subsequent restoration:

- E-13) 1837 GLO post by John Brink, Deputy Surveyor
Hemlock 14 N 60 1/2 W 15,
Hemlock 22 N 35 E 46
- E-13) 1989 N. Livasy LCRC Liber 1, page 809:
Set 1/2" rebar w/cap #31611
Large Stone "x", S 5 W 95.73'
12" Cedar, S 22 E 124.50'
8" Cedar, S 43 E 95.63'

B. Description of corner evidence found and/or method applied in restoring or reestablishing corner:

- E-13) Section corner common to Sections 32 and 33

Found 1/2" Iron per Liber 1, page 809 and is accepted as a the best available evidence of the position of the original corner. Corner is located in the centerline of the East-West road.


C. Description of monument for corner and accessories established to perpetuate locating the position of the corner:

- E-13) Set 2 1/2" brass Missaukee County monument on existing Iron

N 28 E 77.80' 6" R.Pine
S 03 W 95.66' Large Stone "x"
S 23 E 124.36' 16" Cedar
S 44 E 95.60' 10" Cedar

Peer Group Reviewed and Approved
Date: 11-30-94
J. Dean Geers
J. Dean Geers, Missaukee Co. Representative

Signed by *Daniel E. Schripsema*
Surveyor's Michigan License No. _____

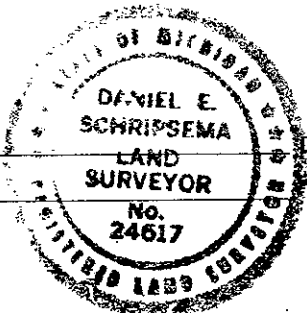

Date 12-30-94