

**SURVEY & REMONUMENTATION**

LIBER 291 PAGE 426

APR 24 1995

**LAND CORNER RECORDATION CERTIFICATE**  
Filing Requirement of Act 74, Mich. P.A. 1970

975

For corners in **COMMISSION**

<u>Missaukee</u> (County)		Located In:	Corner Code #
1. Public Land Survey	T _____	21N 6W	G-13
	R _____		
	T _____		
	R _____		
2. Property Controlling in Section	S _____	T _____	R _____
	S _____	T _____	R _____
3. Miscellaneous Property in Sec.	S _____	T _____	R _____
	S _____	T _____	R _____

MISSAUKEE COUNTY MICHIGAN

RECORDED JAN 23 1995 12 PM

*Carolyn Flare*  
REGISTER

Register of Deeds Stamp & File Number

4. Lot No. \_\_\_\_\_, Recorded Plat \_\_\_\_\_  
5. Private Claims \_\_\_\_\_

	A	B	C	D	E	F	G	H	I	J	K	L	M
2	6	5	4	3	2	1							
3													
4	7	8	9	10	11	12							
5													
6	18	17	16	15	14	13							
7													
8	19	20	21	22	23	24							
9													
10	30	29	28	27	26	25							
11													
12	31	32	33	34	35	36							
13													

I, Daniel E. Schripsema a field survey on December, 19 94, do hereby certify that under requirements of P.A. 74, Michigan P.A. of 1970, the corner points mentioned in lines 1 and 2 above were in conformance with regulations and rules therefore as required in the current manual of survey instructions of the United States Department of the Interior, Bureau of Land Management or by a decree of a Court of Law and/or that the corner points mentioned in lines 3, 4 and 5 above were in conformance with the rules of the Michigan Board of Land Surveyors or by a Decree of a Court of Law; established, re-established, monumented, re-monumented, recovered, found as expressed below:

**NOTE: Not more than 4 corners, all in the same town and range, may be recorded on this certificate.**

A. Description of original monument and accessories and/or subsequent restoration:

- G-13) 1837 GLO post by John Brinks, Deputy Surveyor  
Beech 11 N 56 1/2 E 58, Beech 11 N 53 W 54
- G-13) 1989 N. Livasy LCRC Liber 1, page 810:  
Set 1/2" rebar w/cap #31611  
6" Ash, N 22 E 39.75'  
12" Balsam, S 03 W 62.92'  
4" Maple, N 29 W 58.58'

B. Description of corner evidence found and/or method applied in restoring or reestablishing corner:


- G-13) Section corner common to Sections 33 and 34  
  
Found 1/2" Iron w/cap per Liber 1, page 810 and is accepted as a careful and faithful reestablishment of the original corner. Corner is located in the centerline of the road going in an East-West direction.

C. Description of monument for corner and accessories established to perpetuate locating the position of the corner:

- G-13) Set 2 1/2" brass Missaukee County monument on existing Iron  
  
N 21 E 39.66' 8" Ash  
N 03 W 37.43' Fence Cor. Post  
N 30 W 58.54' 6" Maple  
S 12 W 23.90' Fence Post  
South 62.94' 16" Balsam

Peer Group Reviewed and Approved  
Date: 11-30-94  
*J. Dean Geers*  
J. Dean Geers, Missaukee Co. Representative

Signed by Daniel E. Schripsema  
Surveyor's Michigan License No. 24617

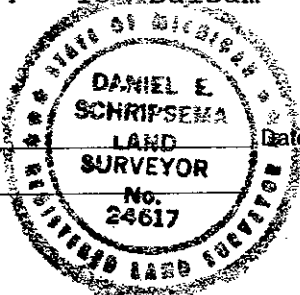

Date 1-12-95