

**SURVEY & REMONUMENTATION**

LIBER 291 PAGE 425

APR 24 1995

**LAND CORNER RECORDATION CERTIFICATE**  
Filing Requirement of Act 74, Mich. P.A. 1970

974

For corners in **MISSAUKEE**

_____	<b>Missaukee</b> (County)	Located In:	Corner Code #
1. Public Land Survey	T <u>21N</u> R <u>6W</u>		<u>H-13</u>
	T _____ R _____		_____
	T _____ R _____		_____
	T _____ R _____		_____
2. Property Controlling in Section	S _____ T _____ R _____		_____
	S _____ T _____ R _____		_____
3. Miscellaneous Property in Sec.	S _____ T _____ R _____		_____
	S _____ T _____ R _____		_____

MISSAUKEE COUNTY MICHIGAN  
RECORDED **JAN 23 1995** 12:01 PM  
*Carolyn Florie*  
REGISTER  
Register of Deeds Stamp & File Number

4. Lot No. \_\_\_\_\_, Recorded Plat \_\_\_\_\_  
5. Private Claims \_\_\_\_\_

	A	B	C	D	E	F	G	H	I	J	K	L	M
2	6	5	4	3	2	1							
3													
4	7	8	9	10	11	12							
5													
6	13	17	16	15	14	13							
7													
8	19	20	21	22	23	24							
9													
10	30	29	28	27	26	25							
11													
12	31	32	33	34	35	36							
13													

I, Daniel E. Schripsema, a field surveyor on December, 19 94, do hereby certify that under requirements of P.A. 74, Michigan P.A. of 1970, the corner points mentioned in lines 1 and 2 above were in conformance with regulations and rules therefore as required in the current manual of survey instructions of the United States Department of the Interior, Bureau of Land Management or by a decree of a Court of Law and/or that the corner points mentioned in lines 3, 4 and 5 above were in conformance with the rules of the Michigan Board of Land Surveyors or by a Decree of a Court of Law; established, re-established, monumented, re-monumented, recovered, found as expressed below:


**NOTE: Not more than 4 corners, all in the same town and range, may be recorded on this certificate.**

- A. Description of original monument and accessories and/or subsequent restoration:
- H-13) 1837 GLO post by John Brink, Deputy Surveyor Hemlock 10 N 34 1/2 E 41, Hemlock 11 N 40 W 20
  - H-13) 1984 M. McClung LCRC Liber 1, page 692: Fd. 3/4" Pipe 2' deep, raised w/5/8" Steel rod; In East and West road and North and South road extended

- B. Description of corner evidence found and/or method applied in restoring or reestablishing corner:
- H-13) Quarter corner common to Section 34, T21N, R6W and Clare County  
Found 5/8" Iron per Liber 1, page 692 and is accepted as a careful and faithful perpetuation of the position of the original corner. Corner is located in the centerline of the East-West road.

- C. Description of monument for corner and accessories established to perpetuate locating the position of the corner:
- H-13) Set 2 1/2" brass Missaukee County monument on existing Iron  
N 35 E 45.53' 10" Tamarack  
West 257.07' DNR 5/8" Iron w/cap  
S 81 W 165.19' 10" Spruce  
S 80 E 150.76' 10" Tamarack

Peer Group Reviewed and Approved  
Date: 11-30-94  
*J. Dean Geers*  
J. Dean Geers, Missaukee Co. Representative

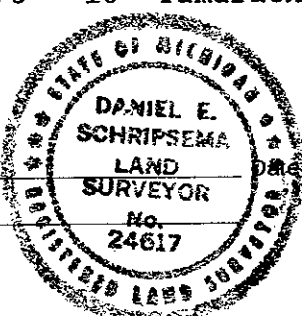

Signed by Daniel E. Schripsema  
Surveyor's Michigan License No. 24617

1-12-95