

SURVEY & MONUMENTATION

LIBER 291 PAGE 424

973

APR 24 1995

LAND CORNER RECORDATION CERTIFICATE
Filing Requirement of Act 74, Mich. P.A. 1970

COMMISSIONER
W. J. Duke

Located In:	Corner Code #
T 21N R 6W	I-13
T _____ R _____	_____
T _____ R _____	_____
T _____ R _____	_____
S _____ T _____ R _____	_____
S _____ T _____ R _____	_____
S _____ T _____ R _____	_____
S _____ T _____ R _____	_____

MISSAUKEE COUNTY MICHIGAN

RECORDED JAN 23 1995 12:01 PM

Paulyn Flare
REGISTER

Register of Deeds Stamp & File Number

Recorded Plat _____

	A	B	C	D	E	F	G	H	I	J	K	L	M
2	6	5	4	3	2	1							
3													
4	7	8	9	10	11	12							
5													
6	18	17	16	15	14	13							
7													
8	19	20	21	22	23	24							
9													
10	30	29	28	27	26	25							
11													
12	31	32	33	34	35	36							
13													

Ipsema a field survey on December, 1994, in accordance with requirements of P.A. 74, Michigan P.A. of 1970, the corner points mentioned here in conformance with regulations and rules therefore as required in the instructions of the United States Department of the Interior, Bureau of Land Management of a Court of Law and/or that the corner points mentioned in lines 3, 4 and 5 were re-established, monumented, re-monumented, recovered, found as

Section 4 corners, all in the same town and range, may be recorded as a single certificate.

Original monument and accessories and/or subsequent restoration:

- 1837 GLO post by John Brink, Deputy Surveyor
Tamarack 11 N 48 1/2 W 10,
Tamarack 10 N 34 E 35
- 1984 M. McClung LCRC Liber 1, page 692:
Set 5/8" Iron rod w/cap
10" Maple (in clump), N 70 E 204.65'
24" Maple, N 80 E 234.55'

Other evidence found and/or method applied in restoring or reestablishing corner:

Section corner common to Sections 34 and 35

Found 5/8" Iron per Liber 1, page 692 and is accepted as a careful and faithful reestablishment of the position of the original corner.

Monument for corner and accessories established to perpetuate locating the position of the corner:


Set 2 1/2" brass Missaukee County monument on existing Iron

- S 52 E 37.20 12" scotch pine
- S 06 E 20.58 8" scotch pine
- S 23 E 95.08 Power Pole
- East 1.0 DNR post

Peer Group Reviewed and Approved

Date: 11-30-94
J. Dean Geers
J. Dean Geers, Missaukee Co. Representative

Shyker
License No. 24617

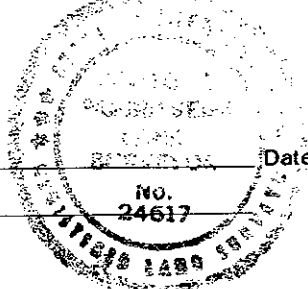

Date 1-12-95