

JAN 19 2000

LIBER 333 PAGE 436

SECTION

LAND CORNER RECORDATION CERTIFICATE
Filing Requirement of Act 74, Mich. P.A. 1970

1348

For corners in

<u>Missaukee County</u>	Located In:	Corner Code #
1. Public Land Survey	T <u>21N</u> R <u>06W</u>	<u>M-4</u>
	T _____ R _____	_____
	F _____ R _____	_____
	T _____ R _____	_____
2. Property Controlling in Section	S _____ T _____ R _____	_____
	S _____ T _____ R _____	_____
3. Miscellaneous Property in Sec.	S _____ T _____ R _____	_____
	S _____ T _____ R _____	_____

MISSAUKEE COUNTY MICHIGAN
RECORDED DEC 09 1999 4⁰⁰ PM
Paula Flare

Register of Deeds Stamp & File Number

4. Lot No. _____, Recorded Plat _____

5. Private Claims _____

I, J. Dean Geers, P.S., in a field survey on June, 19 99 do hereby state that under requirements of P.A. 74, Michigan P.A. of 1970, the corner points mentioned in lines 1 and 2 above were in conformance with regulations and rules therefore as required in the current manual of survey instructions of the United States Department of the Interior, Bureau of Land Management or by a decree of a Court of Law and /or that the corner points mentioned in lines 3, 4 and 5 above were in conformance with the rules of the Michigan Board of Land Surveyors or by a Decree of a Court of Law; established, re-established, monumented, recovered, found as expressed below:

	A	B	C	D	E	F	G	H	I	J	K	L	M
1													
2	6		5		4		3		2		1		
3													
4	7		8		9		10		11		12		
5													
6	16		17		16		15		14		13		
7													
8	19		20		21		22		23		24		
9													
10	30		29		28		27		26		25		
11													
12	31		32		33		34		35		36		
13													

NOTE: Not more than 2 corners, all in the same town and range, may be recorded on this certificate.

A. Description of original monument and accessories and/or subsequent restoration:

- M-4) 1837 GLO Quarter Section Post by John Brink, Deputy Surveyor. 10" Hemlock-S25½W-63 lks, 9" Beech-N60W-37 lks.
- M-4) 1987 Roser survey and LCRC, Liber 1, Page 740; Set DNR monument and Cedar post. 14" Oak-S22E-20.00', 24" Maple-S44W-24.71', 5" White Pine-N66W-51.16', North-South trail (in curve)-EAST-27 ±'.
Re-established corner equal distance and on line between northeast and southeast corners of Section 12 as previously established.


B. Description of corner evidence found and/or method applied in restoring or reestablishing corner:

- M-4) Quarter section corner common to Section 12, T21N, R6W and Section 7, T21N, R5W. Found DNR monument and remains of cedar location post as recorded in Liber 1, Page 740. This corner is accepted as a careful and faithful re-establishment of the position of the original corner. Note: The cabin referenced in the Roser LCRC has apparently been moved or rebuilt. There is a large square sandy area where it used to be.

C. Description of monument for corner and accessories established to perpetuate locating the position of the corner:

- M-4) Found DNR Monument
 - *S15E 20.05' Set nail west face of 14" oak
 - S50W 24.65' Set nail northwest face of 16" maple
 - *N62W 51.21' Set nail south face of 8" white pine
 - North 53.72' Set nail east face of 8" white pine
 - East ± 25' Centerline of trail
 - West 108.2' Southeast corner of cabin

*Previous Witness

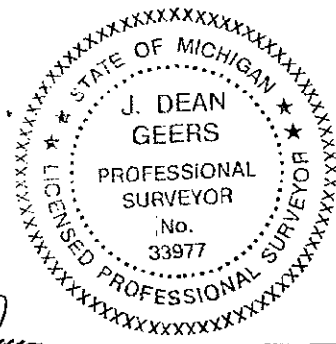

Peer Group Reviewed and Approved

Date: 12-9-99
J. Dean Geers
J. Dean Geers, Missaukee Co. Representative

Signed by *J. Dean Geers*
Surveyor's Michigan License No. 33977

Date 11-23-99