

JAN 19 2000

LIBER 333 PAGE 439

SECTION

LAND CORNER RECORDATION CERTIFICATE
Filing Requirement of Act 74, Mich. P.A. 1970

1351

For corners in

<u>Missaukee County</u>	Located In:	Corner Code #
1. Public Land Survey	T <u>21N</u> R <u>06W</u>	<u>M-7</u>
	T _____ R _____	_____
	T _____ R _____	_____
	T _____ R _____	_____
2. Property Controlling in Section	S _____ T _____ R _____	_____
	S _____ T _____ R _____	_____
3. Miscellaneous Property in Sec.	S _____ T _____ R _____	_____
	S _____ T _____ R _____	_____

MISSAUKEE COUNTY MICHIGAN

RECORDED DEC 09 1999 4:20 PM

Pauline Flare
REGISTRAR

Register of Deeds Stamp & File Number

4. Lot No. _____, Recorded Plat _____

5. Private Claims _____

I, J. Dean Geers, P.S., in a field survey on June, 19 99 do hereby state that under requirements of P.A. 74, Michigan P.A. of 1970, the corner points mentioned in lines 1 and 2 above were in conformance with regulations and rules therefore as required in the current manual of survey instructions of the United States Department of the Interior, Bureau of Land Management or by a decree of a Court of Law and for that the corner points mentioned in lines 3, 4 and 5 above were in conformance with the rules of the Michigan Board of Land Surveyors or by a Decree of a Court of Law; established, re-established, monumented, recovered, found as expressed below:

	A	B	C	D	E	F	G	H	I	J	K	L	M
1													
2	6			5		4		3		2		1	
3													
4	7			8		9		10		11		12	
5													
6	18			17		16		15		14		13	
7													
8	19			20		21		22		23		24	
9													
10	30			29		28		27		26		25	
11													
12	31			32		33		34		35		36	
13													

NOTE: Not more than 2 corners, all in the same town and range, may be recorded on this certificate.

A. Description of original monument and accessories and/or subsequent restoration:


- M-7) 1837 GLO Section Corner Post by John Brink, Deputy Surveyor. 16" Yellow Pine-S78W-34 lks, 16" Yellow Pine-N42W-41 lks.
- M-7) 1852 GLO Section Corner Post recovered by A. Curtis. 6" S. Pine-S30E-6 lks, 18" Y. Pine-N70E-50 lks.
- M-7) 1901 Teed Notes: Found new stake set by someone; Y. Pine southwest ok and remains of Y. Pine northwest and Y. Pine northeast ok: Y. Pine 28-N66W-62 1/2 lks, Y. Pine 24-S64 1/2 E-53 lks.
- M-7) 1938 Schaaf notes. Found post and USBT stumps. Set monument.
- M-7) 1987 Roser survey and LCRC; Liber 1, Page 740; Found 2" x 26" pipe that fits U.S.B.T. stumps, set Cedar post, added DNR monument. 28" Oak-S24E-65.1', 8" Cherry clump-S40W-48.3', 16" Oak-N08W-19.7'.

B. Description of corner evidence found and/or method applied in restoring or reestablishing corner:

- M-7) Section corner common to Section 13, T21N, R6W, Section 24, T21N, R6W, Section 18, T21N, R5W, and Section 19, T21N, R5W. Found DNR monument and cedar location post as recorded in Liber 1, Page 740. This corner is accepted as a careful and faithful perpetuation of the position of the original corner. Possible GLO witness: S82W 22.5' Face of old stump.

C. Description of monument for corner and accessories established to perpetuate locating the position of the corner:

- M-7) Found DNR Monument
 - *S43W 48.23' Set nail in southeast face 10" cherry stump
 - *North 20.06' Set nail in west face 16" oak
 - S60E 14.71' Set nail in northeast face 6" oak
 - S82W 24.89' Set nail in south face 8" cherry
 - N45E ± 82' Edge of swamp
 - *S20E ± 66.0' 28" oak stump
 - *Previous Witness

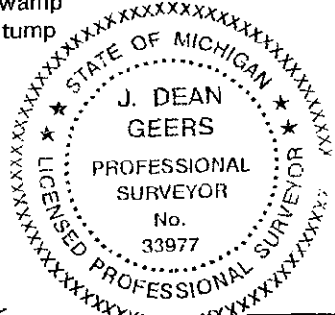

Peer Group Reviewed and Approved
Date: 11-9-99
J. Dean Geers
J. Dean Geers, Missaukee Co. Representative

Signed by *J. Dean Geers*
Surveyor's Michigan License No. 33977

Date 11-23-99