

JAN 19 2000

LIBER 333 PAGE 441

SECTION

LAND CORNER RECORDATION CERTIFICATE  
Filing Requirement of Act 74, Mich. P.A. 1970

#1353

For corners in

<u>Missaukee County</u>	Located In:	Corner Code #
1. Public Land Survey	T <u>21N</u> R <u>06W</u>	<u>M-9</u>
	T _____ R _____	_____
	T _____ R _____	_____
	T _____ R _____	_____
2. Property Controlling in Section	S _____ T _____ R _____	_____
	S _____ T _____ R _____	_____
3. Miscellaneous Property in Sec.	S _____ T _____ R _____	_____
	S _____ T _____ R _____	_____

MISSAUKEE COUNTY MICHIGAN

RECORDED DEC 09 1999 4<sup>00</sup> PM

*Paulyn Flare*  
REGISTER

Register of Deeds Stamp & File Number

4. Lot No. \_\_\_\_\_, Recorded Plat \_\_\_\_\_

5. Private Claims \_\_\_\_\_

I, J. Dean Geers, P.S., in a field survey on June, 19 99 do hereby state that under requirements of P.A. 74, Michigan P.A. of 1970, the corner points mentioned in lines 1 and 2 above were in conformance with regulations and rules therefore as required in the current manual of survey instructions of the United States Department of the Interior, Bureau of Land Management or by a decree of a Court of Law and /or that the corner points mentioned in lines 3, 4 and 5 above were in conformance with the rules of the Michigan Board of Land Surveyors or by a Decree of a Court of Law; established, re-established, monumented, recovered, found as expressed below:

A	B	C	D	E	F	G	H	I	J	K	L	M
1												
2	6		5		4		3		2		1	
3												
4	7		8		9		10		11		12	
5												
6	18		17		16		15		14		13	
7												
8	19		20		21		22		23		24	
9												
10	30		29		28		27		26		25	
11												
12	31		32		33		34		35		36	
13												

NOTE: Not more than 2 corners, all in the same town and range, may be recorded on this certificate.

A. Description of original monument and accessories and/or subsequent restoration:

- M-9) 1837 GLO Section Corner Post by John Brink, Deputy Surveyor. 10" Maple-S68½W-11 lks, 10" Yellow Pine-N32½W-19 lks.
- M-9) 1852 GLO Section Corner Post recovered by A. Curtis, Deputy Surveyor. 7" Hemlock-S56E-17 lks, 6" W. Pine-N30E-8 lks.
- M-9) 1901 Teed notes: Found remains of Maple southwest and Norway northwest and remains of stake. W. Pine 16-N50½W-74 lks, W. Pine 20-S74W-76 lks, Y. pine 12-S74¼W-43 lks.
- M-9) 1938 Schaaf notes, found post. Set monument.
- M-9) 1987 Roser survey and LCRC; Liber 1, Page 750; Found 1½" x 34" pipe, replaced with DNR monument and set Cedar post. 3" Maple-N12E-28.8', 10" Red Pine-S88E-2.1', 5" Red Pine-S08E-13.3', 3" Maple-S60W-49.6', Center East-West black top road-SOUTH-162' ±.
- M-9) 1993 Schripsema Survey, Liber 3, Page 236; Found DNR monument. 3" Maple-N12E-28.8', 10" Red Pine-S88E-2.1', 5" Red Pine-S08E-13.3', 3" Maple-S60W-49.6'.
- M-9) 1994 Schripsema Survey, Liber 3, Page 239; No monument described. 3" Maple-N12E-28.8', 10" Red Pine-S88E-2.1', 5" Red Pine-S08E-13.3', 3" Maple-S60W-49.6'.

B. Description of corner evidence found and/or method applied in restoring or reestablishing corner:


- M-9) Section corner common to Section 24, T21N, R6W, Section 25, T21N, R6W, Section 19, T21N, R5W, and Section 30, T21N, R5W. Found DNR monument and cedar location post as recorded in Liber 1, Page 750. This corner is accepted as a careful and faithful perpetuation of the position of the original corner. Possible GLO witness: N32W 12.6' Possible stump hole.

C. Description of monument for corner and accessories established to perpetuate locating the position of the corner:

M-9) Found DNR Monument

- S70W 45.37' Set nail in south face 5" maple
- S75E 2.38' Set nail in south face 14" red pine
- \*South 13.44' Set nail in west face 8" red pine
- N52E 43.91' Set nail in south face 8" cherry
- South ± 162' Centerline east-west road
- \*N20E 29.0' 8" maple
- \*S65W 49.5' 8" maple

\*Previous Witness

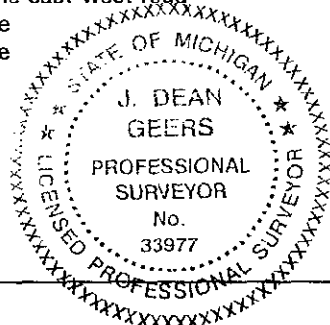

Peer Group Reviewed and Approved

Date: 12-9-99  
J. Dean Geers, Missaukee Co. Representative

Signed by J. Dean Geers  
Surveyor's Michigan License No. 33977

Date 11-23-99