

JAN 19 2000

LIBER 333 PAGE 442

SECTION

LAND CORNER RECORDATION CERTIFICATE
Filing Requirement of Act 74, Mich. P.A. 1970

#1354

For corners in

<u>Missaukee County</u>	Located In:	Corner Code #
1. Public Land Survey	T <u>21N</u> R <u>06W</u>	<u>M-10</u>
	T _____ R _____	_____
	T _____ R _____	_____
	T _____ R _____	_____
2. Property Controlling in Section	S _____ T _____ R _____	_____
	S _____ T _____ R _____	_____
3. Miscellaneous Property in Sec.	S _____ T _____ R _____	_____
	S _____ T _____ R _____	_____

MISSAUKEE COUNTY MICHIGAN
RECORDED DEC 09 1999 4⁰⁰ P.M.
Roslyn Florie
REGISTER
Register of Deeds Stamp & File Number

4. Lot No. _____, Recorded Plat _____
5. Private Claims _____

I, J. Dean Geers, P.S., in a field survey on June, 19 99 do hereby state that under requirements of P.A. 74, Michigan P.A. of 1970, the corner points mentioned in lines 1 and 2 above were in conformance with regulations and rules therefore as required in the current manual of survey instructions of the United States Department of the Interior, Bureau of Land Management or by a decree of a Court of Law and for that the corner points mentioned in lines 3, 4 and 5 above were in conformance with the rules of the Michigan Board of Land Surveyors or by a Decree of a Court of Law; established, re-established, monumented, recovered, found as expressed below:

	A	B	C	D	E	F	G	H	I	J	K	L	M
1													
2	6		5		4		3		2		1		
3													
4	7		8		9		10		11		12		
5													
6	18		17		16		15		14		13		
7													
8	19		20		21		22		23		24		
9													
10	30		29		28		27		26		25		
11													
12	31		32		33		34		35		36		
13													


NOTE: Not more than 2 corners, all in the same town and range, may be recorded on this certificate.

- A. Description of original monument and accessories and/or subsequent restoration:
- M-10) 1837 GLO Quarter Section Post by John Brink, Deputy Surveyor. 24" Yellow Pine-S38½W-91 lks, 10" Beech-N27W-37 lks.
 - M-10) 1901 Teed notes: Found Y. pine southwest ok and remains of stake. W. Pine 30-S86½W-48½ lks, Y. Pine 30-S27E-65½ lks, Y. Pine 46-N39E-68½ lks.
 - M-10) 1938 Schaaf notes; Found post and USBT stump. Set monument.
 - M-10) 1987 Roser survey and LCRC; Liber 1, Page 730; Found 1½" pipe set by Schaaf from USBT stumps and set Cedar post with location tag. 14" Red Pine-N35E-18.9', 8" Maple-N82E-35.1', 6" Maple cluster-S62E-22.7', 9" Cherry-S60W-15.7', North-South random-EAST-9' ±.
 - M-10) 1993 Schripsema Survey; Found 1½" pipe. 14" Red Pine-N35E-18.9', 8" Maple-N82E-35.1', 6" Maple-S62E-22.7', 9" Cherry-S60W-15.7'.

- B. Description of corner evidence found and/or method applied in restoring or reestablishing corner:
- M-10) Quarter section corner common to Section 25, T21N, R6W and Section 30, T21N, R5W. Found 1½" pipe and cedar location post as recorded in Liber 1, Page 730. This corner is accepted as a careful and faithful perpetuation of the position of the original corner.

- C. Description of monument for corner and accessories established to perpetuate locating the position of the corner:
- M-10) Found 1½" pipe and drove 5/8" x 36" rebar into pipe and set Missaukee County Monument.
- | | | |
|-------|--------|--|
| *N83E | 35.13' | Set nail in north face of 8" maple |
| *S62E | 22.53' | Set nail in north face of 6" maple clump |
| S83W | 11.87' | Set nail in southeast face of 5" maple |
| N22W | 50.31' | Set nail in east face of 12" twin cherry |
| S45W | ±56' | Centerline of old logging trail |

*Previous Witness

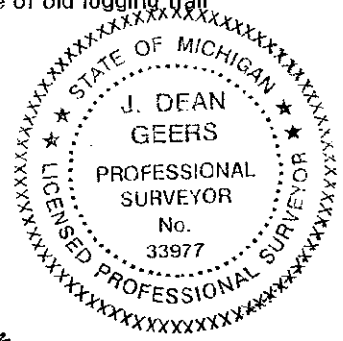

Peer Group Reviewed and Approved
Date: 12-9-99
J. Dean Geers
J. Dean Geers, Missaukee Co. Representative

Signed by *J. Dean Geers*
Surveyor's Michigan License No. 33977

Date 11-23-99